RESPONSIBILITY SCHEDULE

RESPONSIBILITY SCHEDULE

RESPONSIBILITY SCHEDULE

TOE STRIP - JBI
MIRROR TRIM- JBI
BASE FITTING ROOM - JBI
FLAT STOCK- GC SUPPLIED
TOP CAP DETAIL, BOTTOM CAP AND DIVIDER TRIM - JBI

	HOLLISTER DOMESTIC 30684 OWNER / LANDLORD RESPONSIBILITY SCHEDULE	OWNER FURNISHED	OWNER INSTALLED	LANDLORD FURNISHED	LANDLORD INSTALLED	N/A	COMMENTS
	PLEASE NOTE: IF ITEM IS NOT LISTED, IT IS GC RESPONSIBILITY FOR PROCUREMENT AND INSTALL PER THE CONSTRUCTION DOCUMENTS						
DIVISION 01 - GENERAL REQUIREMENTS							
01.01	CONSTRUCTION BARRICADE GRAPHICS	X	X				
01.02	CONSTRUCTION BARRICADE	X	X				G.C. TO SECURE SITE PRIOR TO STORE GRAND OPENING
01.03	TURN OVER AND FINAL CLEAN	X					G.C. TO PERFORM DAILY CLEANING
DIVISION 02 - EXISTING CONDITIONS							
02.01	SELECTIVE DEMOLITION						G.C. TO PERFORM IN AREA OF WORK. REFER TO A1.00
DIVISION 05 - METALS							
05.01	METAL TRIM FOR ROLLING GRILLE SLOT					X	
05.02	STOREFRONT ACM PANELS	X					G.C. TO INSTALL. COLOR MATCHED CAULK PROVIDED BY OWNER.
DIVISION 06 - WOOD, PLASTICS AND COMPOSITES							
06.01	CASHWRAP(S), BACKWRAP(S) AND COUNTERTOPS					X	G.C. TO INSTALL, TOUCH-UP AS NECESSARY
06.02	FITTING ROOM MILLWORK - PRE-FINISHED DOORS AND JAMBS (T-7, T-8, T-9, T-13)						G.C. TO SUPPLY AND INSTALL
06.03	SALES AREA WING WALLS					X	G.C. TO INSTALL
06.04	PRE-FINISHED STOREFRONT CHAIR RAIL TRIM (T-4)	X					G.C. TO INSTALL
06.05	WALL BASE AND CROWN						G.C. TO SUPPLY & INSTALL TO MATCH EXISTING
06.06	STAINED SHIPLAP (T-10)	X					G.C. TO INSTALL
06.07	PRE-FINISHED FITTING ROOM CHAIR RAIL TRIM (T-11)					X	G.C. TO INSTALL
06.08	PRE-FINISHED SHIPLAP FRAME TRIM (T-12)	X					G.C. TO INSTALL
06.09	MIRROR TRIM (T-14)	X					G.C. TO INSTALL & SUPPLY MIRROR GLASS
06.10	FITTING ROOM WAINSCOT PANEL						G.C. TO SUPPLIED AND INSTALLED
06.11	FITTING ROOM PARTITIONS						G.C. TO SUPPLY AND INSTALL TO MATCH EXISTING CONDITIONS
DIVISION 08 - OPENINGS							
08.01	STOREFONT ENTRY DOORS AND HARDWARE	REFER TO DOOR SCHEDULE					
08.02	STOREFRONT OVERHEAD ROLLING GRILLE					X	
08.03	STOREFRONT SIDE FOLDING ENCLOSURE					X	
08.04	INTERIOR DOORS, FRAMES AND HARDWARE	REFER TO DOOR SCHEDULE					
08.05	STOREFRONT GLAZING SYSTEM	X					G.C. TO SUPPLY GLASS AND GASKETS
08.06	STOREFRONT GLAZING CLIPS					X	
DIVISION 09 - FINISHES							
09.01	FLOORING - PORTAL FLOOR HEXTILE FC-2	X					G.C. TO PROVIDE SETTING MATERIALS AND GROUT, AND INSTALL
09.02	FLOORING - WALK-OFF ENTRY MAT	X					EXTERIOR LOCATIONS ONLY
09.03	FLOORING - SALES FLOOR WOOD PLANK	X					WHERE APPLICABLE, G.C. TO INSTALL
09.04	WALLCOVERING	X					G.C. TO PROVIDE PRIMER AND INSTALL
09.05	DRYVIT (SF-59)	X					G.C. TO PROVIDE & INSTALL. REFER TO A8.00
DIVISION 10 - SPECIALTIES							
10.01	STOREFRONT SIGNAGE, DECALS, BLADE SIGN, FITTING ROOM DOOR NUMBERS	X	X				G.C. TO PROVIDE BLOCKING
10.02	NON-SALES ROLLING & FIXED SHELVING, HANGBARS, ROLLING RACK BUMPERS AND PROTECTIVE COVERS	X					
10.03	NON-SALES FIXED WALL SHELVING, STANDARDS AND BRACKETS	X					
10.04	NON-SALES HARDWARE BIN AND BAR BIN	X					
10.05	NON-SALES MANAGER'S WORKSTATION AND CHAIR, PROCESSING AND PREP DESKS	X				X	EXISTING TO REMAIN
10.06	NON-SALES FLOOR MOUNTED SAFE					X	EXISTING TO REMAIN
10.07	NON-SALES EMPLOYEE LOCKERS					X	EXISTING TO REMAIN
10.08	NON-SALES BULLETIN BOARDS					X	EXISTING TO REMAIN
10.09	NON-SALES DELIVERY DOOR VINYL IDENTITY SIGNAGE					X	ONE SIGN PER RECEIVING DOOR
10.10	NON-SALES MICROWAVE AND REFRIGERATOR					X	
10.11	NON-SALES BREAK ROOM TABLE AND CHAIRS					X	ONLY WHERE REQUIRED BY AHJ
10.12	NON-SALES HEALTH AND SAFETY SIGNAGE	X					G.C. TO INSTALL SIGNAGE WITH OWNER FURNISHED PLASTIC ZIP TIES
10.13	NON-SALES EVACUATION PLAN AND FRAMES					X	ONLY WHERE REQUIRED BY AHJ
10.14	NON-SALES TOILET ROOM ACCESSORIES	REFER TO SHEET A11.00 FOR LAVATORY EQUIPMENT SCHEDULE					
10.15	NON-SALES EMPLOYEE LOCKER ROOM BENCH					X	ONLY WHERE REQUIRED BY AHJ
10.16	NON-SALES JANITORIAL ACCESSORIES					X	
10.17	MARKETING GRID AND HARDWARE	X					
10.18	MARKETING BRACKETS, IMAGES, AND BARS	X					G.C. TO CUT METAL POLE TO CORRECT LENGTH IN FIELD
10.21	ILLUMINATED "SKYLIGHT" CEILING FEATURE AND GRAPHICS					X	G.C. TO SUPPLY AND INSTALL HARDWARE, REFER TO A3.00. INSTALL GRAPHICS, REFER TO INSTALLATION GUIDE.
10.22	SALES AREA WALL STANDARDS	X					G.C. TO INSTALL
10.23	PC SHELVES AND HARDWARE	X					G.C. TO INSTALL WALL STANDARDS, REFER TO A7.00.
10.24	DSP CART	X					G.C. TO PAINT BASE OF DSP CART P-63C.
10.25	BOH DOOR KICK AND PUSHPULL PLATE						G.C. TO SUPPLIED AND INSTALL STAINLESS STEEL FINISH
10.26	FIT CABINET CAP						GC. TO SUPPLY AND INSTALL
DIVISION 11 - EQUIPMENT							
11.01	DOOR BELL/BUZZER					X	EXISTING TO REMAIN
11.02	PAPER TOWEL DISPENSER					X	EXISTING TO REMAIN
DIVISION 12 - FURNISHINGS							
12.01	FURNITURE, FLOOR FIXTURES, PLANTS, PROPS AND SEATING	X	X				
12.02	FITTING ROOM ACCESSORIES	X					HANGBARS, HOOKS, GRIDS, SHELF, ETC. G.C. TO PROVIDE BLOCKING AS REQUIRED
DIVISION 14 - CONVEYING SYSTEMS							
14.01	ELEVATOR/LIFT					X	G.C. TO PROVIDE & TERMINATE POWER AND LIFE SAFETY SYSTEMS
DIVISION 21 - FIRE SUPRESSION							
21.01	SYSTEM TAP						EXISTING TO REMAIN. G.C. TO COORDINATE WITH LICENSED FIRE PROTECTION CONTRACTOR (LL REQUIRED VENDOR) TO MAKE SYSTEM MODIFICATIONS AS REQUIRED
DIVISION 23 - HVAC							
23.01	HVAC EQUIPMENT	REFER TO SHEET M1.00 FOR SCHEDULES					
23.02	ENERGY MANAGEMENT SYSTEM (EMS) PANEL	X	X				EXISTING TO BE REUSED AND RECONFIGURED. REFER TO E4.00 AND M2.00 FOR ADDITIONAL INFORMATION. OWNER VENDOR TO INSTALL
23.03	EMS SENSORS	X	X				REFER TO E4.00, M1.00 AND M2.00 FOR ADDITIONAL INFORMATION
23.04	EMS CABLES						G.C. TO PROVIDE AND INSTALL CONDUIT RUNS HIHH AND LOW VOLTAGE WIRE AS DIRECTED PER PLANS. REFER TO E4.00 FOR ADDITIONAL INFORMATION
23.05	EMS COMMISSIONING	X	X				EXISTING TO BE REUSED AND RECONFIGURED. REFER TO E4.00 AND M2.00 FOR ADDITIONAL INFORMATION
DIVISION 26 - ELECTRICAL							
26.01	LANDLORD SWITCHGEAR	REFER TO SHEET E1.00 FOR ELECTRICAL POWER RISER SCHEMATIC					
26.02	LANDLORD DISCONNECT						
26.03	LANDLORD UTILITY METER						
26.04	SERVICE FEEDERS						
26.05	PANELBOARDS						EXISTING TO REMAIN-G.C. TO PROVIDE MODIFICATIONS AS INDICATED. REFER TO SHEET E1.00
26.06	ENERGY METER					X	EXISTING TO REMAIN
26.07	CURRENT LIMITING (CL) PANEL					X	EXISTING TO REMAIN
26.08	LIGHT FIXTURES AND ACCESSORIES	REFER TO SHEET E1.10 FOR SCHEDULES					
26.09	FLOOR MOUNTED TRANSFORMER					X	EXISTING TO REMAIN
DIVISION 27 - COMMUNICATIONS							
27.01	TELECOMMUNICATIONS TECHNOLOGY RACK					X	EXISTING TO REMAIN. REFER TO SHEET E4.00
27.02	TELECOMMUNICATIONS AV AND DATA OUTLETS					X	EXISTING TO REMAIN. REFER TO SHEET E4.00
27.03	TELECOMMUNICATIONS WIRING					X	EXISTING TO REMAIN. REFER TO SHEET E4.00
27.04	POINT OF SALE (POS) EQUIPMENT					X	EXISTING TO REMAIN
27.05	WIRELESS ACCESS POINTS (WAP)					X	EXISTING TO REMAIN
27.06	WAP WIRING					X	EXISTING TO REMAIN
27.07	PEOPLE COUNTER					X	EXISTING TO REMAIN. RELOCATE AS NEEDED
27.08	PEOPLE COUNTER WIRING					X	G.C. TO PROVIDE AND INSTALL CABLING AND CONDUIT RUNS AS NEEDED
27.09	AUDIO SYSTEM EQUIPMENT					X	EXISTING TO REMAIN. REFER TO SHEET E4.00
27.10	AUDIO SYSTEM SPEAKERS					X	EXISTING TO REMAIN. REFER TO SHEET E4.00
27.11	AUDIO SYSTEM WIRING					X	EXISTING TO REMAIN. REFER TO SHEET E4.00
27.12	VIDEO WALL	X	X				G.C. TO PROVIDE POWER
27.13	VIDEO WALL FRAME	X					G.C. TO PROVIDE BLOCKING, REFER TO A7.01
27.14	DIGITAL WAY FINDING SIGNS					X	EXISTING TO REMAIN
27.15	COMMISSIONING AND PROGRAMMING	X	X				
DIVISION 28 - ELECTRONIC SAFETY AND SECURITY							
28.01	ELECTRONIC ARTICLE SURVEILLANCE (EAS) EQUIPMENT	X	X			X	EXISTING TO REMAIN
28.02	EAS WIRING	X	X			X	G.C. TO PROVIDE POWER, CONDUIT, AND ANY REQUIRED FLOOR CUTTING AND PATCHING
28.03	CCTV EQUIPMENT					X	EXISTING TO REMAIN. RELOCATE AS NEEDED
28.04	CCTV CAMERAS					X	EXISTING TO REMAIN. RELOCATE AS NEEDED
28.05	CCTV WIRING					X	G.C. TO PROVIDE AND INSTALL CABLING AND CONDUIT RUNS AS NEEDED
28.06	BURGLAR ALARM SYSTEM (BAS) EQUIPMENT					X	EXISTING TO REMAIN. RELOCATE AS NEEDED
28.07	BAS MOTION DETECTOR					X	EXISTING TO REMAIN. RELOCATE AS NEEDED
28.08	BAS WIRING					X	G.C. TO PROVIDE AND INSTALL CABLING AND CONDUIT RUNS AS NEEDED
DIVISION 3 - PLUMBING							
30.01	PLUMBING FIXTURES					X	EXISTING TO REMAIN

AND CLAMPS TO BE PRESEVERED FOR REINSTALLATION

RESPONSIBILITY SCHEDULE NOTES

1. 'NON-SALES' INCLUDES- RESTROOMS, STOCKROOM, ELECTRICAL AND CLOSETS, U.N.O.
2. 'SALES' INCLUDES: MEN'S, WOMEN'S, PORTAL, FITTING ROOMS, FITTING ROOM HALLWAY, U.N.O.
3. G.C. IS TO RECEIVE AND INSTALL OWNER SUPPLIED MATERIALS (OSM) AS SHOWN IN DRAWINGS, DESCRIBED IN SPECIFICATIONS AND/OR AS DIRECTED BY OWNER'S PROJECT MANAGER.
4. OWNER SUPPLIED MATERIALS (OSM) ARE BACK OF TRACK DELIVERY ONLY. OSM WILL BE DELIVERED TO THE CLOSEST AVAILABLE TRUCK DOCK OR OTHER LOCATION AS COORDINATED WITH AND DIRECTED BY THE LANDLORD. GC IS RESPONSIBLE TO UNLOAD, COUNT, INSPECT FOR DAMAGE AND SHALL REPORT DISCREPANCIES, DAMAGES OR MISSING ITEMS TO OWNER'S PROJECT MANAGER WITHIN 48 HOURS OF RECEIPT. GC SHALL TRANSPORT OSM FROM THE POINT OF OFF-LOAD TO THE JOBSITE. MATERIAL OF QUESTIONABLE QUALITY SHALL NOT BE ACCEPTED AND/OR INSTALLED, OTHERWISE IT WILL BE REPLACED AT CONTRACTOR'S EXPENSE. G.C. TO CROSS CHECK LOAD PLAN VS PACKING LIST VS DRAWINGS.
5. G.C. IS RESPONSIBLE FOR DAMAGE, LOSS, THEFT OR DESTRUCTION OF OWNER SUPPLIED MATERIALS. G.C. WILL BE BACK-CHARGED THE FULL COST OF REPLACEMENT MATERIALS INCLUDING FREIGHT CHARGES. REVIEW SPECIFICATIONS FOR ADDITIONAL INFORMATION.
6. G.C. TO COORDINATE INSTALLATION OF OWNER SUPPLIED MATERIALS DIRECTLY W/ OWNER'S VENDORS AND PERTAINS TO DELIVERY, SCHEDULE AND INSTALLATION.
7. G.C. TO PROVIDE SITE COORDINATED MECHANICAL AND ELECTRICAL DRAWINGS. G.C. IS TO UNDERTAKE DETAILED COORDINATION OF MEP SERVICES INSTALLATION. THIS PROCESS IS TO BE LED BY THE MECHANICAL CONTRACTOR AND MUST INCLUDE ELECTRICAL, LIGHTING, SPRINKLER AND STRUCTURAL INSTALLATION.

HOLLISTER
CALIFORNIA

ABERCROMBIE & FITCH CO.
6301 FITCH PATH
NEW ALBANY, OHIO 43054
614-283-6500

SHREMSHOCK
Timothy J. Shremshock, Architect
tim@shremshock.com
www.shremshock.com
Shremshock Architecture, Inc.
7775 Walton Parkway Ste. 250 New Albany, OH 43054
t: 614 545 4500 | f: 614 545 4555

THE ARCHITECT / ENGINEER ASSUMES NO RESPONSIBILITY OR LIABILITY FOR THE USE OF THESE PLANS FOR ANY PROJECT OTHER THAN SPECIFICALLY AUTHORIZED BY THEM AND SIGNED AND SEALED FOR SUCH SPECIFIC LOCATION IN THE STATE OF ORIGINAL PREPARATION. THE BUILDING USE IS ONLY APPLICABLE IN REFERENCE TO THE STATED DESIGN CRITERIA.

THE AVENUE OF MURFREESBORO

2615 MEDICAL CENTER PARKWAY
MURFREESBORO, TN 37129
STORE #3684

Project No.:	260356
Drawn By:	CWH
Date	Issue
10-12-2026	BID SET


RESPONSIBILITY SCHEDULE

A0.10


Plot date: OCT 13 2025

DOOR TYPES


NOTE: REFER TO DOOR SCHEDULE FOR ACTUAL DIMENSIONS AND FIRE RATINGS. REFER TO CONSTRUCTION PLAN FOR DOOR HINGE ORIENTATION.

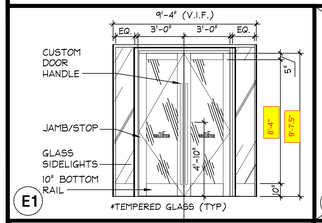


E1

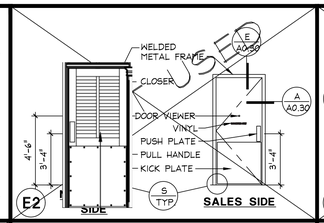


E2

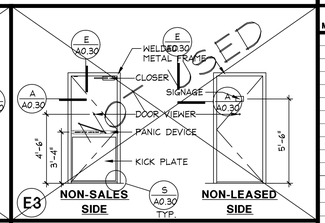


E3

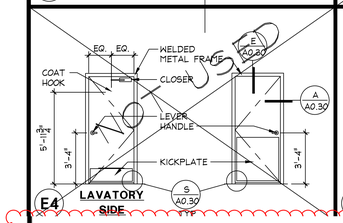

E4

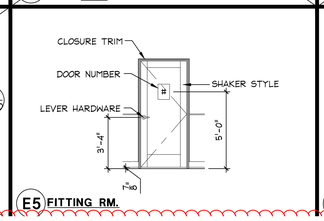


E5 FITTING RM.

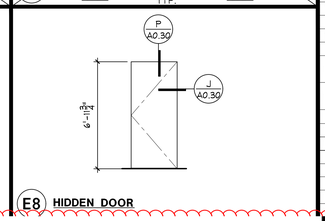


E8 HIDDEN DOOR


DETAILS NEEDED FROM AS-BUILTS. REFER TO A0.10 FOR RESPONSIBILITY OF WORK.

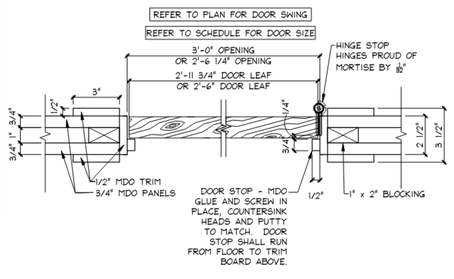

T A0.30 FITTING ROOM DOOR JAMB
SCALE: 3" = 1'-0"

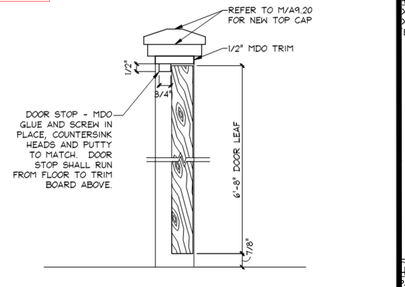

P A0.30 FITTING ROOM DOOR HEAD
SCALE: 3" = 1'-0"

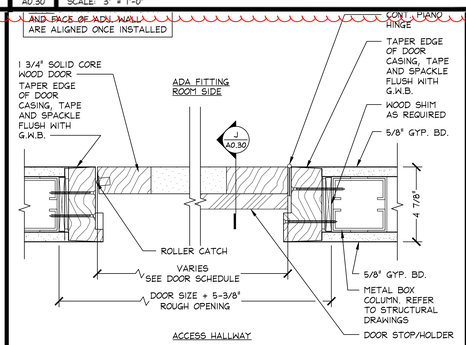

P A0.30 BLIND DOOR PLAN DETAIL
SCALE: 3" = 1'-0"


DOOR AND FRAME SCHEDULE

MARK	LOCATION	DOOR SUPPLIED BY	DOOR TYPE	HARDWARE SET	FIRE RATING	WIDTH	HEIGHT	THICKNESS	DOOR MATERIAL	FRAME MATERIAL	DOOR & FRAME FINISH	HEAD	JAMB	SILL	NOTES
100	PORTAL	G.C.	E1	HW1C		PR. 3'-0"	9'-7.5"	MFGR.	GLASS	ALUMINUM	RAL 5011	-	-	-	G.C. TO FIELD VERIFY OPENING. SEE A8.00 FOR ADDITIONAL INFORMATION.
120A	FITTING	G.C.	E5	HW7	-	3'-0"	7'-0"	1 3/8"	WOOD	WOOD	P-59C	-	-	-	
120B	FITTING	G.C.	E5	HW7	-	3'-0"	7'-0"	1 3/8"	WOOD	WOOD	P-59C	-	-	-	
120C	FITTING	G.C.	E5	HW7	-	3'-0"	7'-0"	1 3/8"	WOOD	WOOD	P-59C	-	-	-	
120D	ADA FITTING	G.C.	E5	HW7	-	3'-0"	7'-0"	1 3/8"	WOOD	WOOD	P-59C	-	-	-	
120E	FITTING	G.C.	E5	HW7	-	3'-0"	7'-0"	1 3/8"	WOOD	WOOD	P-59C	-	-	-	
120F	FITTING	G.C.	E5	HW7	-	3'-0"	7'-0"	1 3/8"	WOOD	WOOD	P-59C	-	-	-	
120G	FITTING	G.C.	E5	HW7	-	3'-0"	7'-0"	1 3/8"	WOOD	WOOD	P-59C	-	-	-	
120H	HIDDEN DOOR	G.C.	E8A	HW6a		2'-6"	7'-0"	1 3/8"	WOOD	-	MATCH ADJACENT	P/A0.30	J/A0.30	-	PAINT GRADE HOLLOW CORE WOOD DOOR AND FRAME, TO BE FLUSH WITH AND MATCH ADJ. WALLS
121A	FITTING	G.C.	E5	HW7	-	3'-0"	7'-0"	1 3/8"	WOOD	WOOD	P-59C	-	-	-	
121B	FITTING	G.C.	E5	HW7	-	3'-0"	7'-0"	1 3/8"	WOOD	WOOD	P-59C	-	-	-	
121C	FITTING	G.C.	E5	HW7	-	3'-0"	7'-0"	1 3/8"	WOOD	WOOD	P-59C	-	-	-	
121D	ADA FITTING	G.C.	E5	HW7	-	3'-0"	7'-0"	1 3/8"	WOOD	WOOD	P-59C	-	-	-	
130A	(E) HALLWAY	EXIST.	EXIST.	EXIST.	-	3'-0"	7'-0"	1 3/4"	HOLLOW METAL	H.M. (WELDED)	EXIST.	-	-	-	COORDINATE EXTENT OF EXISTING HARDWARE TO REMAIN w/ P.M. G.C. TO SUPPLY NEW KICKPLATE AND PUSH/PULL PLATE
130B	(E) SERVICE DOOR	EXIST.	EXIST.	EXIST.	-	3'-0"	7'-0"	1 3/4"	HOLLOW METAL	H.M. (WELDED)	EXIST.	-	-	-	COORDINATE EXTENT OF EXISTING HARDWARE TO REMAIN w/ P.M. G.C. TO SUPPLY NEW KICKPLATE
131	(E) MANAGER'S AREA	EXIST.	EXIST.	EXIST.		3'-0"	7'-0"	1 3/4"	HOLLOW METAL	H.M. (WELDED)	EXIST.	-	-	-	COORDINATE EXTENT OF EXISTING HARDWARE TO REMAIN w/ P.M.
132A	(E) STOCKROOM	EXIST.	EXIST.	EXIST.	-	3'-0"	7'-0"	1 3/4"	HOLLOW METAL	H.M. (WELDED)	EXIST.	-	-	-	COORDINATE EXTENT OF EXISTING HARDWARE TO REMAIN w/ P.M.
132B	(E) SERVICE DOOR	EXIST.	EXIST.	EXIST.	-	3'-0"	7'-0"	1 3/4"	HOLLOW METAL	H.M. (WELDED)	EXIST.	-	-	-	COORDINATE EXTENT OF EXISTING HARDWARE TO REMAIN w/ P.M. G.C. TO SUPPLY NEW KICKPLATE
133	ACCESS HALLWAY	G.C.	E8	HW6a		2'-6"	7'-0"	1 3/8"	WOOD	-	MATCH ADJACENT	P/A0.30	J/A0.30	-	PAINT GRADE HOLLOW CORE WOOD DOOR AND FRAME, TO BE FLUSH WITH AND MATCH ADJ. WALLS
134	DISPLAY AREA	G.C.	E8	HW6a		2'-6"	7'-0"	1 3/8"	WOOD	-	MATCH ADJACENT	P/A0.30	J/A0.30	-	PAINT GRADE HOLLOW CORE WOOD DOOR AND FRAME, TO BE FLUSH WITH AND MATCH ADJ. WALLS
140A	(E) UNISEX RESTROOM	EXIST.	EXIST.	EXIST.	-	3'-0"	7'-0"	1 3/4"	HOLLOW METAL	H.M. (WELDED)	EXIST.	-	-	-	COORDINATE EXTENT OF EXISTING HARDWARE TO REMAIN w/ P.M.
140B	(E) UNISEX RESTROOM	EXIST.	EXIST.	EXIST.	-	3'-0"	7'-0"	1 3/4"	HOLLOW METAL	H.M. (WELDED)	EXIST.	-	-	-	COORDINATE EXTENT OF EXISTING HARDWARE TO REMAIN w/ P.M.
40C	(E) MOP CLOSET	EXIST.	EXIST.	EXIST.	-	PR. 3'-0"	7'-0"	1 3/4"	HOLLOW METAL	H.M. (WELDED)	EXIST.	-	-	-	COORDINATE EXTENT OF EXISTING HARDWARE TO REMAIN w/ P.M.


DOOR HARDWARE

HARDWARE QUANTITIES ARE PER DOOR OPENING, UNLESS NOTED OTHERWISE


HARDWARE SET	HARDWARE COMPONENT	QTY.	SUPPLIED BY	DESCRIPTION
HW1C (DOUBLE DOOR ENTRY EXTERIOR)	BUTT HINGES	6	OWNER	(3) PER DOOR LEAF - P094N DARK BRONZE W/ S070 DARK BRONZE SCREWS
	HANDLE & TRIM	2	OWNER	CUSTOM EXTERIOR BACK TO BACK PULL HANDLES, 6'-6 1/4" (1988MM) TALL I 1/2" (40MM) DIA. FOUR POST ATTACHEMENTS. FINISH: BLACK ANODIZED W/ BLACK SPACERS
	PANIC	2	OWNER	ONLY IF REQUIRED BY CODE - FIRST CHOICE 3600 CONCEALED VERTICAL ROD EXIT DEVICES
	CYLINDER	1	OWNER	DORMA INSTAKEY STANDARD LOCK CYLINDER. FINISH: BRUSHED ALUMINUM. 5-PIN SMALL FORMAT/ INTERCHANGEABLE LOCK (PROVIDE EXTERIOR KEYED CYLINDER ON ONE LEAF ONLY AND INTERIOR THUMB TURN ON OTHER)
	LOCK	1	OWNER	MS LOCKS ADAMS RITE 1853A
	DUST PROOF STRIKE	1	OWNER	ROCKWOOD #570 AND PLATE - ALIGN W/ FLUSH BOLT (CUT IN FIELD BY GC) W/ MOUNTING PLATE #572 BLACK FINISH
	CLOSER	2	OWNER	INTERNATIONAL SERIES 300 OVERHEAD CONCEALED CLOSERS WITH SIDE ARM (105 DEGREE HOLD OPEN) (ADA ADJUSTABLE)
	THRESHOLD	1	OWNER	NGP #425 x MILL FINISH
	DOOR SWEEP	2	OWNER	TUBELITE E2059, FINISH TO MATCH STOREFRONT, INCLUDE VINYL PARTS #P-916 & P-830
	FLUSH BOLTS	2	OWNER	STANDARD EDGE MOUNTED #P059
	NOTES: A. DORMA STYLE 'F' UNIVERSAL HARDWARE B. DO NOT PAINT HARDWARE			
HW2 (PASSAGE SINGLE)	HINGES	3	G.C.	STANLEY #FBB-179, 4 1/2" X 4 1/2" FINISH : US26D SATIN CHROME
	PUSH PLATE	1	G.C.	SALES SIDE - 4"W X 16"H STAINLESS STEEL PUSH PLATE
	PULL HANDLE/ PLATE	1	G.C.	NON-SALES SIDE OF DOOR - 4"W X 16"H STAINLESS STEEL W/ 7/8"W X 11 3/4"H PUSH PULL D-HANDLE. FINISH: STAINLESS STEEL.
	CLOSER	1	G.C.	CORBIN RUSSWIN (PARALLEL ARM) DOOR CLOSER #DC3210, MOUNTED ON PULL SIDE
	DOOR STOP	1	OWNER	IVES #RS448 HEAVY DUTY HOLDER W/ BUTTON. FINISH: SATIN CHROME (US26D) SET INCLUDES STOP, HOOK, MOUNTING PLATE AND SCREWS
	KICK PLATE	2	G.C.	(1) 40"W X 32"H X 1/16"T STAINLESS STEEL FINISH - SALES SIDE (42" DOOR) (1) 40"W X 32"H X 1/16"T STAINLESS STEEL FINISH - NON-SALES SIDE (42" DOOR)
	DOOR VIEWER	1	G.C.	TO BE INSTALLED SO VIEW IS OUT; FROM NON-SALES TO SALES
	NIGHTLOCK	1	OWNER	NIGHTLOCK DOWN 8' LOW PROFILE FLOOR PLATE BY NIGHTLOCK DOOR SECURITY DEVICES PHONE: (855) 644-4856
HW3 (RESTROOM SINGLE)	HINGES	3	G.C.	STANLEY #FBB-179, 4 1/2" X 4 1/2" FINISH : US26D SATIN CHROME
	LATCHSET	1	G.C.	PRIVACY SET CORBIN RUSSWIN #CL3520 NZD BHMA 626 WITH LEVER HANDLE
	CLOSER	1	G.C.	CORBIN RUSSWIN (PARALLEL ARM) DOOR CLOSER #DC3210, MOUNTED ON RESTROOM SIDE OF DOOR.
	KICK PLATE	2	G.C.	(1) 34"W X 32"H X 1/16"T STAINLESS STEEL KICK PLATE (OUTSIDE) (1) 34"W X 12"H X 1/16"T STAINLESS STEEL KICK PLATE (INSIDE)
	COAT HOOK	1	G.C.	McMASTER CARR #1760A3, ALUMINUM FINISH. MOUNTED ON INSIDE OF DOOR @ 72" A.F.F. OR 48" A.F.F. ON ADJACENT WALL BASED ON LOCAL CODE REQUIREMENTS, MOUNT INTO WALL STUD.
	DOOR STOP	1	OWNER	IVES FS444, FINISH US26D. SATIN CHROME
HW4 (REAR EXIT (SINGLE)	DOOR ALARM	1	G.C.	DETEX EAX-500
	HINGES	3	G.C.	STANLEY HINGE #FBB-179 NRP, 4 1/2" X 4 1/2" FINISH : US26D SATIN CHROME
	CLOSER	1	G.C.	CORBIN RUSSWIN (PARALLEL ARM) DOOR CLOSER #DC3210, MOUNTED ON PUSH SIDE OF DOOR.
	KICKPLATE	1	G.C.	(1) 40"W X 32"H X 1/16"T STAINLESS STEEL FINISH
	DOOR VIEWER	1	G.C.	McMASTER-CARR CAT. 104, PART #5906A26 DULL CHROME; MOUNTED @ 54" A.F.F.
	DOOR STOP	1	OWNER	IVES FS444, FINISH: US26D. SATIN CHROME; FLOOR MOUNTED
	SMOKE SEAL	1	G.C.	PEMKO #S88C, COLOR: CLEAR
	DOOR GUARD	1	G.C.	INSTALLED BY OWNER; HONEYWELL SECURITY 'DOORGUARD' WITH BAS TIE IN, NON-SALES SIDE (WHERE REQUIRED) SEE LOSS PREVENTION DRAWINGS.
	CYLINDER LOCK	1	OWNER	CYLINDER INSTAKEY LOCKSET W/ CYLINDER AND TRIM INSTALLED IN PUSH BAR, FINISH: US26D SATIN CHROME
	NOTES: A. EXISTING DOORS 1. INSPECT EXISTING HARDWARE AND REPORT CONDITION TO THE OWNER'S PROJECT MANAGER. 2. REPLACE HINGES AS SPECIFIED IF EXISTING HINGES ARE NOT NRP TYPE. 3. REMOVE EXISTING LOCKSET AND INSTALL PANIC HARDWARE AS SPECIFIED. 4. INSTALL APPLICABLE HARDWARE AS REQUIRED/DIRECTED BY OWNER'S PROJECT MANAGER. 5. PROVIDE CLOSURE PLATES AND SEAL ALL OPENINGS AS REQUIRED. B. INSTALL STORE IDENTITY SIGNAGE ON THE EXTERIOR OF THE DOOR. MOUNT PER ELEVATION (OR PER LANDLORD REQUIREMENTS) WITH NO VISIBLE MOUNTING HOLES. COORDINATE WITH OWNER'S PROJECT MANAGER AND LANDLORD ON-SITE REPRESENTATIVE. C. IF THE INSTALLATION OF A DOOR VIEWER IS NOT PERMITTED, REFER TO ELECTRICAL DRAWINGS FOR INTERCOM SYSTEM SPECIFICATIONS.			
HW6a HIDDEN DOOR	HINGES	1	G.C.	SELECT CONTINUOUS PIANO HINGE
	ROLLER LATCH	2	G.C.	ROLLER LATCH: IVES RL32xUS26D
	CLOSER	1	G.C.	GLYNN-JOHNSTON 9045 MILL FINISH
HW7 FITTING ROOM (SINGLE)	HINGES	3	OWNER	HINGE, HAGER BB1279, 4.5" X 4.5", SQUARE CORNERS, US26D SATIN CHROME PLATED FINISH
	LOCKSET	1	OWNER	HAGER 3580 X WTN SCC 26D, 6-PIN, SCHLAGE CLASSIC 'C' KEYWAY KEYED TO 436373, 2 3/4" BACKSET DOOR BOLT, 4 7/8" STRIKE (STOREROOM, SATIN CHROME)
	HINGE STOP	1	OWNER	HINGE PIN STOP, DON-JO #1512, 619 SATIN NICKEL FINISH
	NOTES: A. HANDLES TO POINT TOWARD HINGE SIDE OF DOOR B. ALL LOCKSETS ARE KEYED ALIKE C. G.C. TO PROVIDE CLEAR SILENCER RUBBER BUMPERS D. SHIPPED LOOSE FOR G.C. TO INSTALL ONSITE			

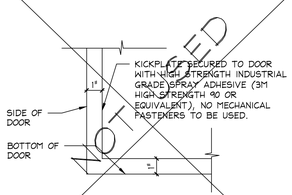


S A0.30 KICKPLATE
SCALE: 3" = 1'-0"

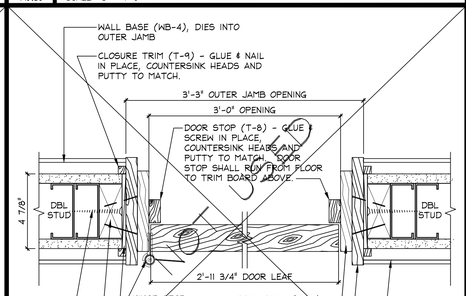


N A0.30 FITTING ROOM/OMNI DOOR JAMB
SCALE: 3" = 1'-0"

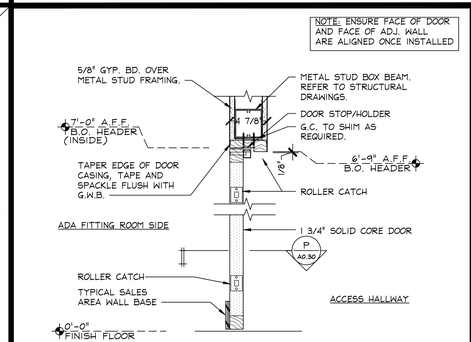

J A0.30 HIDDEN DOOR SECTION
SCALE: 1-1/2" = 1'-0"

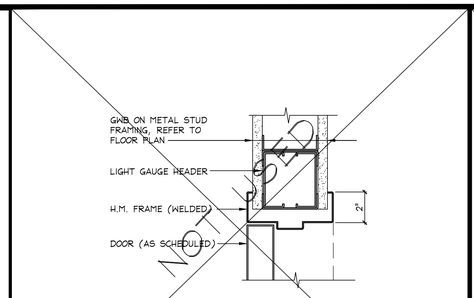

E A0.30 SALES/NON-SALES DOOR - HEAD
SCALE: 3" = 1'-0"

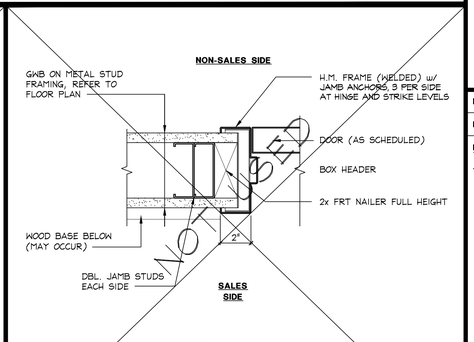

A A0.30 SALES/NON-SALES DOOR - JAMB
SCALE: 3" = 1'-0"

HOLLISTER CALIFORNIA
ABERCROMBIE & FITCH CO.
6301 FITCH PATH
NEW ALBANY, OHIO 43054
614-283-6500

SHREMSHOCK
Shremshock Architecture, Inc.
7775 Walton Parkway Ste. 250 New Albany, OH 43054
t: 614 545 4555 | f: 614 545 4555
Timothy J. Shremshock, Architect
info@shremshock.com
www.shremshock.com

THE ARCHITECT / ENGINEER ASSUMES NO RESPONSIBILITY OR LIABILITY FOR THE USE OF THESE PLANS FOR ANY PROJECT OTHER THAN SPECIFICALLY AUTHORIZED BY THEM AND SIGNED AND SEALED FOR SUCH SPECIFIC LOCATION IN THE FORM OF A DATED LETTER BEARING THEIR SEAL. THIS BUILDING USE IS ONLY APPLICABLE IN AREAS MEETING THE STATED DESIGN CRITERIA.

THE AVENUE OF MURFREESBORO


2615 MEDICAL CENTER PARKWAY
MURFREESBORO, TN 37129
STORE #3684

Project No.:	260356
Drawn By:	XXX
Date	Issue
10-12-2026	BID SET

DOOR & HARDWARE SCHEDULE

A0.30

Plot date: OCT 13 2025

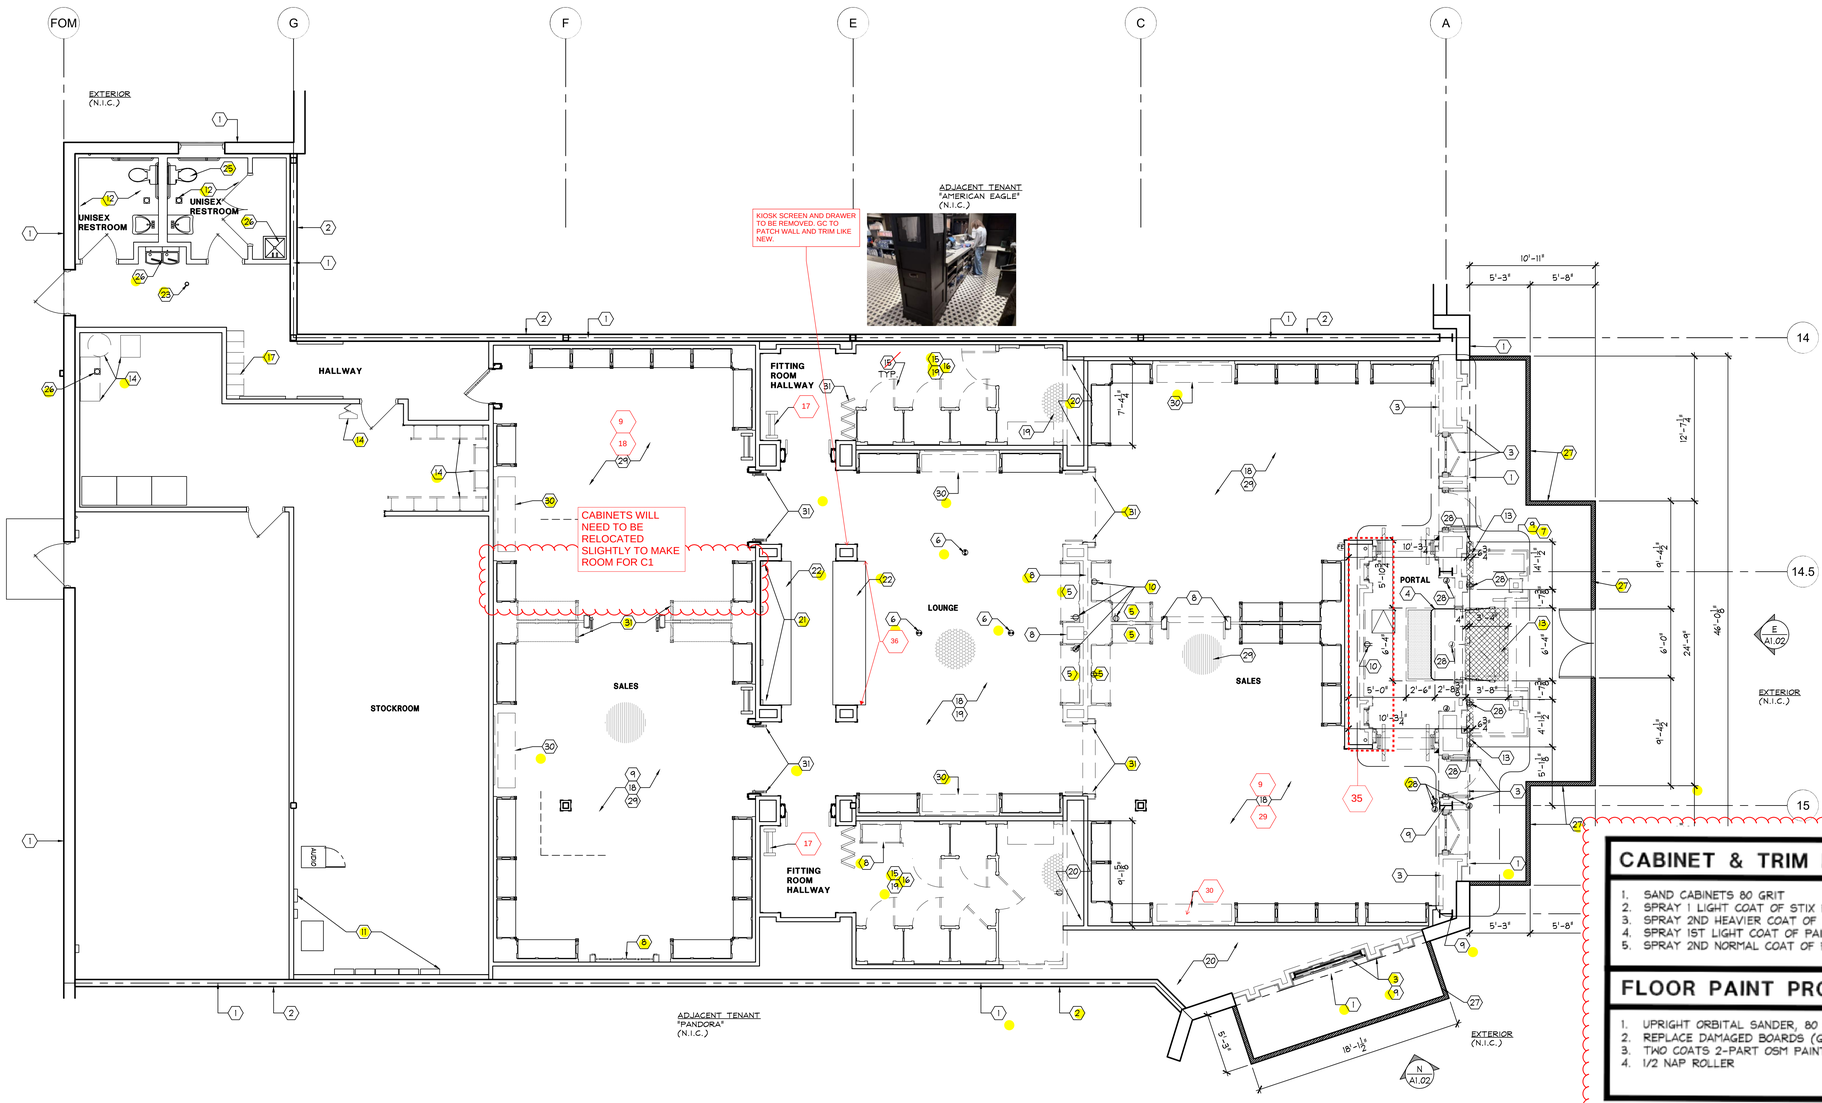

DEMOLITION & EXISTING CONDITIONS FLOOR PLAN

SCALE: 3/16"=1'-0"

ADD NOTE TO SAVE AND PROTECT ALL HVAC CONTROLS/ PANELS AND CABLING FOR RE-USE.

NOTE:
EXISTING HVAC EQUIPMENT, MAIN DUCTS AND UTILITIES SERVING SAID EQUIPMENT SHALL REMAIN IN PLACE AND OPERATIONAL FOR THE DURATION OF THE CONSTRUCTION UNTIL SPECIFIED UNITS ARE PRESENT ON SITE. COORDINATE EXTENT OF DUCTWORK REMOVAL w/ NEW AND PROVIDE RECOMMENDATIONS FOR RE-WORK/REMOVAL OF EXISTING EQUIPMENT/DUCTWORK FOR TEMPORARY CONDITIONING OF THE SPACES TO THE P.M.

CONSTRUCTION BARRICADE NOTES

A. IF CONSTRUCTION BARRICADE IS EXISTING OR INSTALLED BY LANDLORD, PREPARE FACE OF CONSTRUCTION BARRICADE PER OWNER'S STANDARDS FOR GRAPHIC INSTALLATION.

B. CONSULT WITH MALL REPRESENTATIVE FOR HOURS IN WHICH WORK ON CONSTRUCTION BARRICADE CAN OCCUR.

C. TEMPORARY PRE-MANUFACTURED CONSTRUCTION BARRICADE SUPPLIED AND INSTALLED BY OWNER'S VENDOR. COORDINATE INSTALLATION WITH VENDOR AND LANDLORD PRIOR TO START OF CONSTRUCTION. ALIGN DOOR IN BARRICADE w/ ENTRY PORTAL FOR FIXTURE DELIVERY AFTER MALL HOURS

D. MAINTAIN REQUIRED MINIMUM CLEARANCES FROM CONSTRUCTION BARRICADE TO NEAREST PERMANENT FIXTURE IN MALL CONCOURSE TO MAINTAIN THIS BUILDING'S EGRESS REQUIREMENTS. IF MINIMUM EGRESS CLEARANCE CANNOT BE OBTAINED THEN COORDINATE WITH MALL OPERATIONS TO TEMPORARILY RELOCATE KIOSK OR FIXTURES. IF KIOSK OR FIXTURES CANNOT BE RELOCATED, THEN NOTIFY P.M. IMMEDIATELY.

E. CONSTRUCTION BARRICADE TO BE 100% COMPLETE AND READY FOR OWNER'S GRAPHICS TO BE INSTALLED NOT MORE THAN FOUR DAYS AFTER CONSTRUCTION START. CONTACT P.M. UPON COMPLETION TO COORDINATE GRAPHIC INSTALL WITH GRAPHIC VENDOR.

F. MAINTAIN CONSTRUCTION BARRICADE DURING CONSTRUCTION. REPORT ANY DAMAGES TO P.M. IF BARRICADE SUPPLIED BY A&F OR MALL OPERATIONS IF SUPPLIED BY LANDLORD.

G. ALL DELIVERIES TO SPACE DURING MALL HOURS SHALL BE MADE THROUGH SECONDARY EXIT. CONSTRUCTION BARRICADE DOORS FOR FIXTURE & OVERSIZED MATERIAL DELIVERY AFTER MALL HOURS.

H. COORDINATE REMOVAL OF CONSTRUCTION BARRICADE, WITH LANDLORD, WHEN 100% OF STOREFRONT IS COMPLETE OR A MINIMUM OF TWO NIGHTS PRIOR TO OPENING. CARE IS TO BE TAKEN WHEN DISASSEMBLING AND REMOVING CONSTRUCTION BARRICADE.

I. RESTORE MALL FLOORING AND BULKHEAD/CEILING TO A "LIKE NEW" CONDITION AND FINISH AFTER REMOVAL OF CONSTRUCTION BARRICADE.

CODED NOTES

1. LEASE LINE
2. EXISTING TENANT SEPARATION WALL TO REMAIN.
3. REMOVE EXISTING STOREFRONT SYSTEM, PILASTERS, AND ENTRY DOORS (SHOWN DASHED) DOWN TO EXISTING SHELL BUILDING STRUCTURE. PROTECT EXISTING STRUCTURE AND PREPARE FOR NEW STOREFRONT BUILD-OUT.
4. G.C. TO TRENCH FOR NEW EAS CONDUIT. REFER TO S/A9.00 FOR ADDITIONAL INFORMATION.
5. DISASSEMBLE SELECTED EXISTING CABINETS (SHOWN DASHED) AND ASSOCIATED SHUTTER. SELECTED CABINETS TO BE REUSED IN DIFFERENT LOCATIONS. DESTROY AND DISPOSE OF ALL OTHER CABINETS SELECTED TO BE REMOVED. COORDINATE WITH A2.00. G.C. TO SAVE EXISTING CAPITALS AND RELOCATE WITH CABINETS. IF CABINETS ARE NEEDED CONTACT TO ANF PM.
6. EXISTING FLOOR OUTLETS TO REMAIN WITH NO POWER. G.C. TO INSTALL COVER PLATES AS REQUIRED TO BE FLUSH WITH EXISTING FLOOR FINISHES.
7. REMOVE ALL NON STRUCTURAL ELEMENTS INSIDE THE SCOPE OF LIMITS AS SHOWN. INCLUDING, BUT NOT LIMITED TO: INTERIOR WALLS, CABINETS, DOOR & FRAMES, TRIM, CEILINGS, ELECTRICAL & MECHANICAL APPURTENANCES IN ENTIRE AREA OF WORK - U.N.O. REFER TO MEP AND STOREFRONT DRAWINGS FOR ADDITIONAL DIRECTIVES.
8. REMOVE ALL FIXTURES, TABLES, RUGS, SEATING, HANGERS, CABINET SHELVES, ETC. EXISTING CABINET HARDWARE TO REMAIN.
9. PROTECT STRUCTURAL COLUMNS, BEAMS, JOISTS, DECK AND APPLIED FIRE PROTECTION (WHERE APPLICABLE) DURING WORK. REPAIR DAMAGED OR MISSING FIRE PROTECTION TO MAINTAIN ORIGINAL DESIGN RATING PRIOR TO COMMENCING WITH NEW CONSTRUCTION.
10. EXISTING ELECTRICAL OUTLETS TO BE REMOVED AND RELOCATED IN COORDINATION WITH DISPLAY CASES. REFER TO ELECTRICAL DRAWINGS
11. EXISTING ELECTRICAL EQUIPMENT. REFER TO ELECTRICAL DRAWINGS FOR ADDITIONAL DIRECTIVES.
12. EXISTING RESTROOMS FINISHES, ACCESSORIES AND PLUMBING FIXTURES TO REMAIN UNO. G.C. TO DEEP CLEAN RESTROOM AS REQUIRED
13. REMOVE PORTION OF EXISTING CONCRETE SLAB AND GRADE FOR FOR NEW FROST SLAB. REFER TO STRUCTURAL AND COORDINATE WITH CONSTRUCTION PLANS
14. REMOVE BOH FIXTURES & EQUIPMENT SHOWN DASHED.
15. G.C. TO REMOVE EXISTING FITTING ROOM DOORS AND HARDWARE (INCLUDING HOOKS) AND REPLACE WITH NEW. G.C. SUPPLIED. G.C. TO FIELD VERIFY OPENING DIMENSIONS NEEDED AND SUPPLY. WITH THE NEW HEIGHT THE G.C. IS RESPONSIBLE TO PATCH AND MORTISE NEW HINGES. JAMBS EXISTING TO REMAIN. NEW HINGES WILL BE PROVIDED O.S.M. REFER TO A0.30 DOOR SCHEDULE.
16. EXISTING FITTING ROOM PARTITION SYSTEM TO REMAIN.
17. PRESERVE AND RELOCATE LOCKERS, SEE A5.00.
18. PREP EXISTING FLOORS, WALLS & MILLWORK TO RECEIVE NEW FINISHES. REFER TO FINISH PLAN AND INTERIOR ELEVATIONS
19. EXISTING TILE FLOORING TO REMAIN AND BE STEAM CLEANED. GC TO REPAIR/REPLACE TO LIKE NEW CONDITIONS.
20. PREPARE EXISTING SLAB TO RECEIVE SELF-LEVELING UNDERLAYMENT PER SECTION 03 5400. VERIFY CONDITION OF EXISTING SLAB UPON COMPLETE DEMOLITION OF LEASE AREA. NOTIFY P.M. IF CONDITION REQUIRES REMEDIATION TO RECEIVE NEW FINISHES.
21. EXISTING BACKWRAP GYPSUM BOARD AND SURFBOARDS WITH ASSOCIATED MOUNTING HARDWARE TO BE REMOVED. PREPARE FOR INSTALL OF OWNER SUPPLIED SHIPLAP TRIM
22. EXISTING CASHWRAP/BACKWRAP TO REMAIN. PREP FOR NEW FINISHES-REFER TO A9.02
23. EXISTING PLUMBING CLEANOUT TO REMAIN. G.C. TO ENSURE IT IS IN GOOD WORKING ORDER. REFER TO PLUMBING DRAWINGS
24. REMOVE EXISTING OUTLETS AND JUNCTION BOXES AND ASSOCIATED WIRING. REFER TO ELECTRICAL DRAWINGS FOR ADDITIONAL INFORMATION
25. REMOVE EXISTING TOILET AND ACCESSORIES. MAINTAIN PLUMBING CONNECTIONS FOR NEW WORK.
26. PLUMBING FIXTURE TO REMAIN (MOP SINK, DRINKING FOUNTAIN, DRAIN, LAVATORY)
27. TEMPORARY PRE-MANUFACTURED CONSTRUCTION BARRICADE SUPPLIED AND INSTALLED BY VENDOR. COORDINATE INSTALLATION WITH VENDOR AND LANDLORD PRIOR TO START OF CONSTRUCTION. ALIGN DOOR IN BARRICADE WITH ENTRY PORTAL FOR FIXTURE DELIVERY AFTER MALL HOURS. DOOR TO BE CENTERED ON NEW PROPOSED ENTRY LOCATION FOR NEW STOREFRONT.
28. REMOVE EXISTING JUNCTION BOXES, OUTLETS AND CONDUIT AND ASSOCIATED ELECTRICAL WIRING AS REQUIRED.
29. EXISTING WOOD FLOORING TO REMAIN. PATCH / REPAIR AS REQUIRED.
30. REMOVE EXISTING MARKETING CLAMPS AND BAR. SAVE FOR REINSTALLATION AFTER NEW FINISHES ARE INSTALLED.
31. REMOVE EXISTING SHUTTERS AND HARDWARE AT ALL OPENINGS, TYP. IN SALES AREA.
32. EXISTING LANDLORD NEUTRAL PIER. PROTECT DURING CONSTRUCTION.
33. REMOVE LIGHTING AND REWORK OUTLET POWER TO USE FOR NEW SCONCES. REFER TO ELECTRICAL DRAWINGS FOR MORE INFORMATION.
34. KIOSK SCREEN TO BE REMOVED AND GC TO PATCH AND REPAIR WALL LIKE NEW.
35. REMOVE EXISTING VIDEO WALL AND PREP OPENING FOR INFILL. REFER TO A2.00 AND ELECTRICAL PLANS FOR MORE INFO.
36. REMOVING LIGHTING AND REWORK OUTLET POWER TO USE FOR NEW SCONCES. REFER TO A9.01 AND ELECTRICAL DRAWINGS FOR MORE INFORMATION

GENERAL NOTES

A. PLAN SHOWN MAY NOT DEPICT THE ENTIRE EXTENT OF THE EXISTING CONDITIONS, INTERIOR LAYOUT AND EXTENT OF REQUIRED DEMOLITION.

B. WITHIN (2) DAYS OF COMMENCEMENT OF CONSTRUCTION, OR WITHIN (2) DAYS FOLLOWING COMPLETION OF DEMOLITION, CAREFULLY EXAMINE THE AREA OF WORK AND REPORT ANY DISCREPANCIES TO THE PROJECT MANAGER (P.M.) WITHIN THE LEASEHOLD DIMENSIONS OR CONFLICTS BETWEEN THE PHYSICAL SPACE AND THE INTENT OF THE WORKING DRAWINGS. (PAY SPECIAL ATTENTION TO CEILING HEIGHTS AND STOREFRONT DESIGN INTENT.)

C. REMOVE ALL EXISTING LEASEHOLD IMPROVEMENTS NOT REQUIRED TO REMAIN AS SHOWN ON PLAN. DEMOLITION INCLUDES BUT IS NOT LIMITED TO THE REMOVAL OF SPECIFIED INTERIOR MALL PARTITIONS, CEILINGS, FLOOR COVERINGS, PLATFORMS, DISPLAY SHOW WINDOWS, CABINETS, ETC. DEMOLITION ALSO INCLUDES THE REMOVAL OF EXISTING ELECTRICAL, MECHANICAL AND PLUMBING FIXTURES AND EQUIPMENT AS SPECIFIED ON MECHANICAL & ELECTRICAL DRAWINGS BOTH WITHIN THE LEASE SPACE AND ON THE ROOF (WHERE APPLICABLE). CONTACT THE P.M. IF THERE ARE ANY QUESTIONS CONCERNING THE EXTENT OF DEMOLITION.

D. REMOVE ALL EXISTING MECHANICAL EQUIPMENT AND DUCTWORK NOT BEING USED OR NOT SERVING OTHER TENANT SPACES. DO NOT ABANDON ANY EXISTING DUCTWORK OR EQUIPMENT IN PLACE AND SHALL BE REMOVED BACK TO SOURCE.

E. CHECK AND REPAIR ALL EXISTING OVERHEAD SANITARY AND STORM DRAIN LINES FOR LEAKS DURING DEMOLITION. IF UTILITIES SERVE A TENANT ABOVE OR BELOW (WHERE APPLICABLE), REPORT LEAKS TO LANDLORD'S SITE REPRESENTATIVES & OWNER'S REPRESENTATIVES FOR DIRECTION. DO NOT MAKE CORRECTIONS WITHOUT AUTHORIZATION.

F. COORDINATE THE REMOVAL, DISCONNECTION AND/OR CAPPING OF ANY UTILITIES w/ THE P.M.

G. FOLLOW THE LANDLORD'S DEMOLITION REQUIREMENTS/LIMITATIONS AND COORDINATE A CONVENIENT TIME TO PERFORM THE WORK w/ THE LANDLORD . INSTALL TEMPORARY PROTECTED MEANS OF EGRESS, LIGHTING AND SAFETY DEVICES IN ACCORDANCE WITH ALL w/ AUTHORITIES HAVING JURISDICTION, BUILDING REGULATIONS AND LANDLORD REQUIREMENTS.

H. PATCH OR REPAIR EXISTING FLOOR SLAB, DEMISING WALLS AND ROOFING AFTER COMPLETION OF ALL DEMOLITION AND PRIOR TO THE COMMENCEMENT OF NEW CONSTRUCTION. COORDINATE WITH LANDLORD PRIOR TO PERFORMING ANY ROOF WORK. PATCH, REPAIR AND LEVEL EXISTING FLOOR SLAB AND INFORM THE P.M. OF ANY SEVERE IRREGULARITIES IN EXISTING SLAB IMMEDIATELY.

I. COVER ANY RETURN AIR OPENINGS PRIOR TO DEMOLITION.

J. ALL REUSED EQUIPMENT AND UTILITIES ARE TO BE REFURBISHED TO "LIKE NEW" CONDITION.

K. EXERCISE EXTREME CARE DURING DEMOLITION SO AS NOT TO DAMAGE OR DISRUPT UTILITIES OR SPRINKLER LINES WHICH ARE NOT TO BE RELOCATED AND PASS THROUGH THE SPACE TO SERVE ADJACENT SPACES OR OTHER TENANTS. G.C. WILL BEAR SOLE RESPONSIBILITY OF ANY SUCH DISRUPTION OR DAMAGE.

L. REMOVE EXISTING PLUMBING FIXTURES INCLUDING TOILETS, LAVATORIES AND DRINKING FOUNTAINS. REUSE WATER AND SANITARY LINES ASSOCIATED WITH EXISTING FIXTURE FOR CONNECTION OF NEW TOILET, LAVATORY AND DRINKING FOUNTAIN, WHERE APPLICABLE.

M. COORDINATE THE REMOVAL, DISPOSAL AND/OR RETURN OF EXISTING SECURITY SYSTEMS (WHERE APPLICABLE) WITH P.M. PRIOR TO ITS REMOVAL. FAILURE TO DO SUCH COORDINATION WILL RESULT IN G.C. MONETARY FINE IN THE EQUIVALENT OF THE COST OF REPLACEMENT VALUE OF THE EXISTING SECURITY SYSTEM.

N. NOTIFY P.M. IMMEDIATELY OF ANY SEVERE DISCREPANCIES OR IRREGULARITIES DISCOVERED DURING DEMOLITION WHICH MAY AFFECT THE CURRENT STORE DESIGN. PAY SPECIAL ATTENTION TO AVAILABLE HEIGHT FOR INTENDED CEILING ELEVATION, MECHANICAL DUCTWORK, RECESSED LIGHTING AND ACCESS TO SIGNAGE.

O. ALL DEMOLITION WORK SHOWN ON PLAN IS SUBJECT TO REVIEW AND APPROVAL BY LANDLORD'S REPRESENTATIVES. VERIFY ANY DEMOLITION WORK REQUIRED BY LANDLORD THAT IS NOT SHOWN ON PLANS OR THAT MAY REQUIRE THE USE OF LANDLORD APPROVED CONTRACTORS.

CABINET & TRIM PAINT PREP

REFER TO SPECIFICATIONS

1. SAND CABINETS 80 GRIT
2. SPRAY 1 LIGHT COAT OF STIX PRIMER - LET DRY 8 HOURS
3. SPRAY 2ND HEAVIER COAT OF STIX PRIMER - LET DRY 24 HOURS
4. SPRAY 1ST LIGHT COAT OF PAINT - LET DRY 8 HOURS
5. SPRAY 2ND NORMAL COAT OF PAINT

FLOOR PAINT PROCESS

REFER TO SPECIFICATIONS

1. UPRIGHT ORBITAL SANDER, 80 GRIT. SAND SEVERAL COATS DOWN.
2. REPLACE DAMAGED BOARDS (GET COUNT ON DAY ONE)
3. TWO COATS 2-PART OSM PAINT
4. 1/2 NAP ROLLER

HOLLISTER CALIFORNIA
ABERCROMBIE & FITCH CO.
6301 FITCH PATH
NEW ALBANY, OHIO 43054
614-283-6500

SHREMSHOCK
Shremshock Architecture, Inc.
7775 Walton Parkway Ste. 250 New Albany, OH 43054
t: 614.545.4500 | f: 614.545.4555
Timothy J. Shremshock, Architect
info@shremshock.com
www.shremshock.com

THE ARCHITECT / ENGINEER ASSUMES NO RESPONSIBILITY OR LIABILITY FOR THE USE OF THESE PLANS FOR ANY PROJECT OTHER THAN SPECIFICALLY AUTHORIZED BY THEM AND SIGNED AND SEALED FOR SUCH SPECIFIC LOCATION IN THE SEAL AND SIGNATURE BLOCK APPEARING ON THE SEAL. THIS BUILDING USE IS ONLY APPLICABLE IN AREAS MEETING THE STATED DESIGN CRITERIA.

THE AVENUE OF MURFREESBORO


2615 MEDICAL CENTER PARKWAY
MURFREESBORO, TN 37129
STORE #3684

Project No.:	260356
Drawn By:	CWH
Date	Issue
10-12-2026	BID SET

DEMOLITION & EXISTING CONDITIONS FLOOR PLAN

A1.00

Plot date: OCT 13 2025

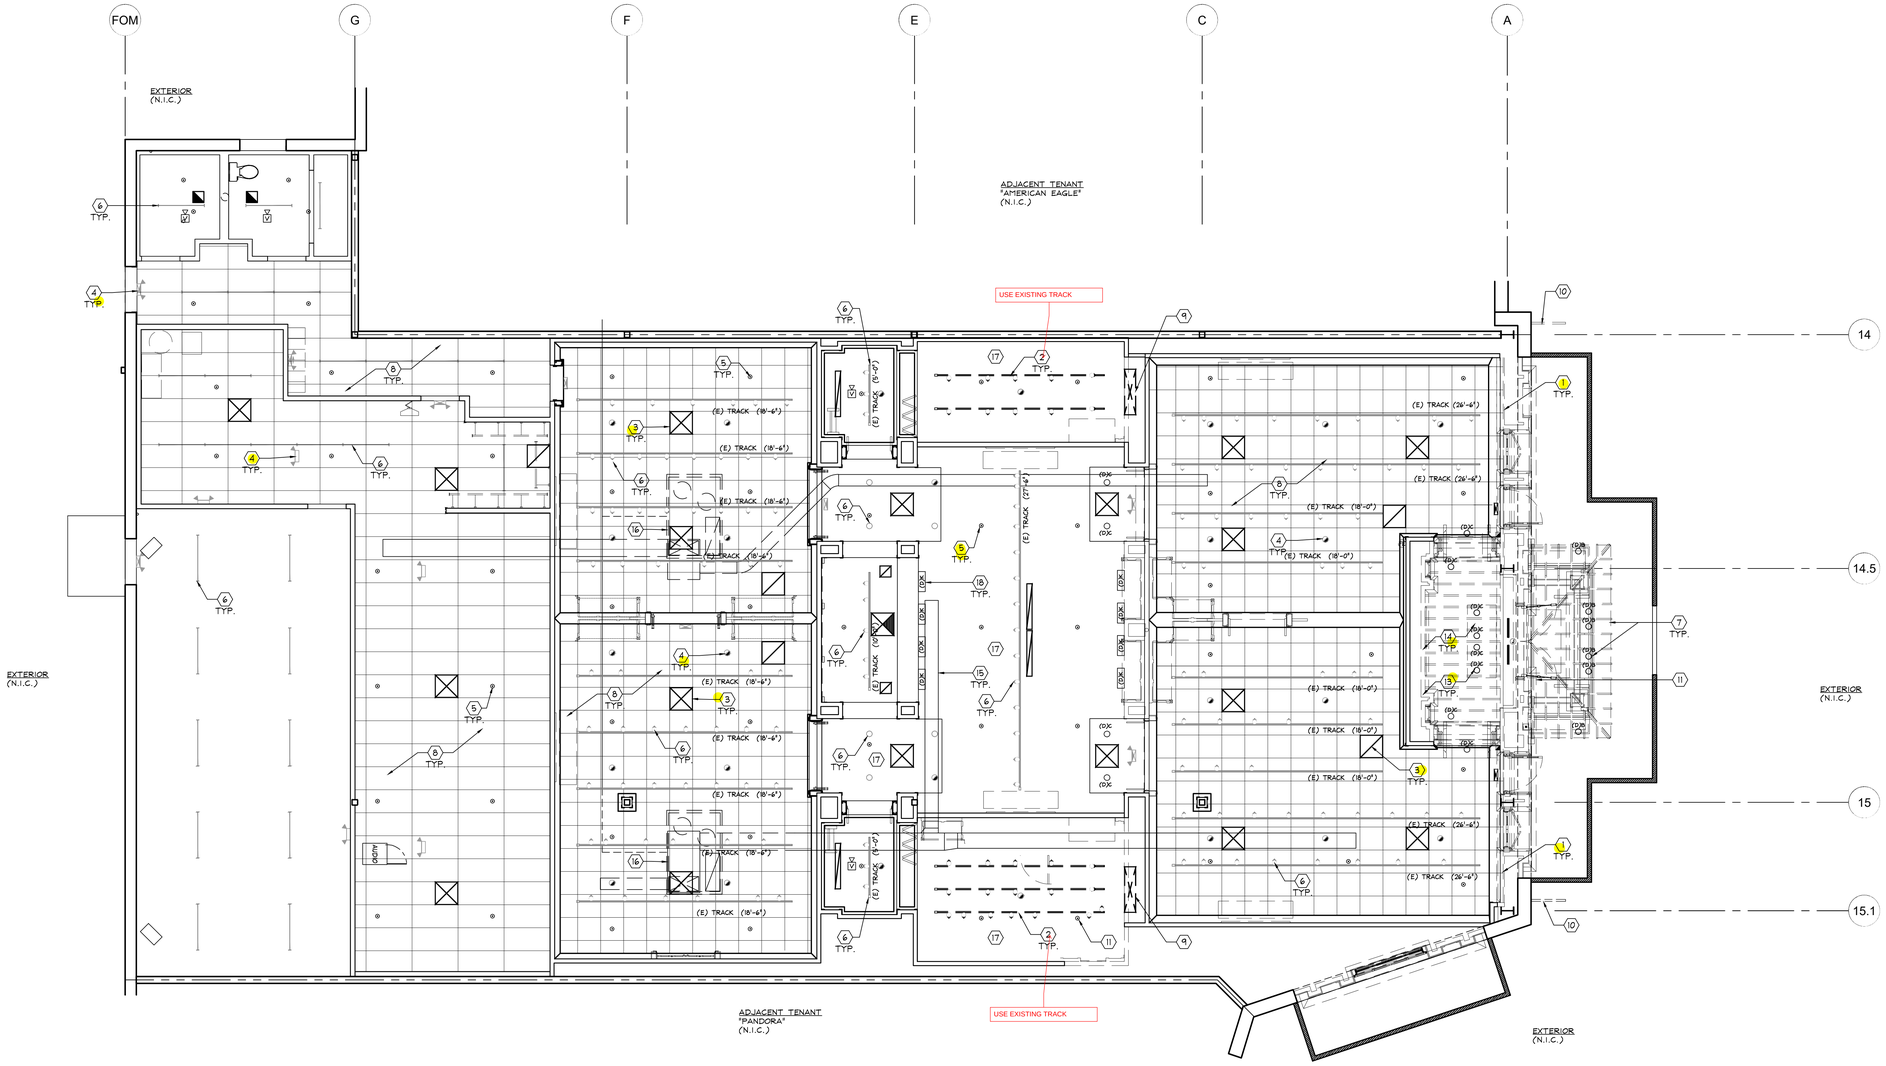

DEMOLITION & EXISTING CONDITIONS CEILING PLAN

SCALE: 3/16"=1'-0"

NOTE:
EXISTING HVAC EQUIPMENT, MAIN DUCTS AND UTILITIES SERVING SAID EQUIPMENT SHALL REMAIN IN PLACE AND OPERATIONAL FOR THE DURATION OF THE CONSTRUCTION UNTIL SPECIFIED UNITS ARE PRESENT ON SITE. COORDINATE EXTENT OF DUCTWORK REMOVAL w/ NEW AND PROVIDE RECOMMENDATIONS FOR RE-WORK/REMOVAL OF EXISTING EQUIPMENT/DUCTWORK FOR TEMPORARY CONDITIONING OF THE SPACES TO THE P.M.

CONSTRUCTION BARRICADE NOTES

A. IF CONSTRUCTION BARRICADE IS EXISTING OR INSTALLED BY LANDLORD, PREPARE FACE OF CONSTRUCTION BARRICADE PER OWNER'S STANDARDS FOR GRAPHIC INSTALLATION.

B. CONSULT WITH MALL REPRESENTATIVE FOR HOURS IN WHICH WORK ON CONSTRUCTION BARRICADE CAN OCCUR.

C. TEMPORARY PRE-MANUFACTURED CONSTRUCTION BARRICADE SUPPLIED AND INSTALLED BY OWNER'S VENDOR. COORDINATE INSTALLATION WITH VENDOR AND LANDLORD PRIOR TO START OF CONSTRUCTION. ALIGN DOOR IN BARRICADE w/ ENTRY PORTAL FOR FIXTURE DELIVERY AFTER MALL HOURS

D. MAINTAIN REQUIRED MINIMUM CLEARANCES FROM CONSTRUCTION BARRICADE TO NEAREST PERMANENT FIXTURE IN MALL CONCOURSE TO MAINTAIN THIS BUILDING'S EGRESS REQUIREMENTS. IF MINIMUM EGRESS CLEARANCE CANNOT BE OBTAINED THEN COORDINATE WITH MALL OPERATIONS TO TEMPORARILY RELOCATE KIOSK OR FIXTURES. IF KIOSK OR FIXTURES CANNOT BE RELOCATED, THEN NOTIFY P.M. IMMEDIATELY.

E. CONSTRUCTION BARRICADE TO BE 100% COMPLETE AND READY FOR OWNER'S GRAPHICS TO BE INSTALLED NOT MORE THAN FOUR DAYS AFTER CONSTRUCTION START. CONTACT P.M. UPON COMPLETION TO COORDINATE GRAPHIC INSTALL WITH GRAPHIC VENDOR.

F. MAINTAIN CONSTRUCTION BARRICADE DURING CONSTRUCTION. REPORT ANY DAMAGES TO P.M. IF BARRICADE SUPPLIED BY A&F OR MALL OPERATIONS IF SUPPLIED BY LANDLORD.

G. ALL DELIVERIES TO SPACE DURING MALL HOURS SHALL BE MADE THROUGH SECONDARY EXIT. CONSTRUCTION BARRICADE DOORS FOR FIXTURE & OVERSIZED MATERIAL DELIVERY AFTER MALL HOURS.

H. COORDINATE REMOVAL OF CONSTRUCTION BARRICADE, WITH LANDLORD, WHEN 100% OF STOREFRONT IS COMPLETE OR A MINIMUM OF TWO NIGHTS PRIOR TO OPENING. CARE IS TO BE TAKEN WHEN DISASSEMBLING AND REMOVING CONSTRUCTION BARRICADE.

I. RESTORE MALL FLOORING AND BULKHEAD/CEILING TO A "LIKE NEW" CONDITION AND FINISH AFTER REMOVAL OF CONSTRUCTION BARRICADE.

CODED NOTES (#)

1. REMOVE EXISTING CEILING / SOFFIT SHOWN DASHED.
2. REMOVE EXISTING TRACK LIGHTING PREPARE EXISTING CIRCUIT FOR NEW FIXTURE.
3. EXISTING RETURNS & DIFFUSERS TO REMAIN, PREP ARE REQUIRED TO BE PAINTED.
4. EXISTING EMERGENCY FIXTURES TO REMAIN.
5. EXISTING SPRINKLER HEADS / SYSTEM TO REMAIN.
6. EXISTING LIGHT FIXTURES TO REMAIN, G.C. TO CONFIRM PROPER WORKING ORDER AND RE-LAMP AS REQUIRED.
7. REMOVE EXISTING EXTERIOR CANOPY AND RELATED EXTERIOR LIGHTING. TERMINATE ANY ABANDONED CIRCUITS BACK TO SOURCE.
8. EXISTING CEILING TILE TO REMAIN U.N.O. PATCH / REPAIR AS REQUIRED IF RECEIVING NEW PAINT.
9. AIR DEVICE TO BE RELOCATED. REFER TO MECHANICAL DRAWINGS FOR ADDITIONAL INFORMATION.
10. EXISTING ILLUMINATED BLADE SIGN TO BE REMOVED.
11. EXISTING SPRINKLER HEAD TO BE RELOCATED / REMOVED TO ALLOW NEW WORK.
12. EXISTING TRACK HEADS, TO BE REMOVED AND SALVAGED FOR POTENTIAL RE-USE
13. REMOVE EXISTING ENTRY AREA CEILING SHOWN DASHED. REMOVE EXISTING LIGHT FIXTURES IN ENTRY AREA, MAINTAIN EXISTING CIRCUIT AS REQUIRED FOR NEW FIXTURES, REFER TO ELECTRICAL DRAWINGS FOR MORE INFORMATION..
14. KEEP EXISTING CROWN MOLDING AT THIS LOCATION. REMOVE EXISTING VIDEO WALL AND PREP OPENING FOR INFILL. REFER TO A2.00 AND ELECTRICAL PLANS FOR MORE INFO.
15. EXISTING MECHANICAL EQUIPMENT G.C. TO CONFIRM AT CONSTRUCTION START.
16. REMOVE EXISTING HVAC EQUIPMENT, REFER TO MECHANICAL AND STRUCTURAL DRAWINGS FOR MORE INFORMATION.
17. EXISTING BARREL CEILING TO REMAIN. G.C. TO PREP FOR NEW FINISHES..
18. REMOVE EXISTING LIGHT FIXTURES AND ASSOCIATED OUTLETS POWERING THE LIGHT FIXTURES AND REPLACED WITH JUNCTION BOXES WITH A FLUSH MOUNTED COVER PLATE FINISHED TO MATCH ADJACENT FINISHES ON CASHWRAP BULKHEAD. CONTRACTOR TO PROVIDE A PULLSTRING FROM PANEL TO JUNCTION BOX FOR POSSIBLE FUTURE USE; CLEARLY LABELED ON EACH END.

GENERAL NOTES

A. PLAN SHOWN MAY NOT DEPICT THE ENTIRE EXTENT OF THE EXISTING CONDITIONS, INTERIOR LAYOUT AND EXTENT OF REQUIRED DEMOLITION.

B. WITHIN (2) DAYS OF COMMENCEMENT OF CONSTRUCTION, OR WITHIN (2) DAYS FOLLOWING COMPLETION OF DEMOLITION, CAREFULLY EXAMINE THE AREA OF WORK AND REPORT ANY DISCREPANCIES TO THE PROJECT MANAGER (P.M.) WITHIN THE LEASEHOLD DIMENSIONS OR CONFLICTS BETWEEN THE PHYSICAL SPACE AND THE INTENT OF THE WORKING DRAWINGS. (PAY SPECIAL ATTENTION TO CEILING HEIGHTS AND STOREFRONT DESIGN INTENT.)

C. REMOVE ALL EXISTING LEASEHOLD IMPROVEMENTS NOT REQUIRED TO REMAIN AS SHOWN ON PLAN. DEMOLITION INCLUDES BUT IS NOT LIMITED TO THE REMOVAL OF SPECIFIED INTERIOR WALL PARTITIONS, CEILINGS, FLOOR COVERINGS, PLATFORMS, DISPLAY SHOW WINDOWS, CABINETS, ETC. DEMOLITION ALSO INCLUDES THE REMOVAL OF EXISTING ELECTRICAL, MECHANICAL AND PLUMBING FIXTURES AND EQUIPMENT AS SPECIFIED ON MECHANICAL DRAWINGS BOTH WITHIN THE LEASE SPACE AND ON THE ROOF (WHERE APPLICABLE). CONTACT THE P.M. IF THERE ARE ANY QUESTIONS CONCERNING THE EXTENT OF DEMOLITION.

D. REMOVE ALL EXISTING MECHANICAL EQUIPMENT AND DUCTWORK NOT BEING USED OR NOT SERVING OTHER TENANT SPACES. DO NOT ABANDON ANY EXISTING DUCTWORK OR EQUIPMENT IN PLACE AND SHALL BE REMOVED BACK TO SOURCE.

E. CHECK AND REPAIR ALL EXISTING OVERHEAD SANITARY AND STORM DRAIN LINES FOR LEAKS DURING DEMOLITION. IF UTILITIES SERVE A TENANT ABOVE OR BELOW (WHERE APPLICABLE), REPORT LEAKS TO LANDLORD'S SITE REPRESENTATIVES & OWNER'S REPRESENTATIVES FOR DIRECTION. DO NOT MAKE CORRECTIONS WITHOUT AUTHORIZATION.

F. COORDINATE THE REMOVAL, DISCONNECTION AND/OR CAPPING OF ANY UTILITIES w/ THE P.M.

G. FOLLOW THE LANDLORD'S DEMOLITION REQUIREMENTS/LIMITATIONS AND COORDINATE A CONVENIENT TIME TO PERFORM THE WORK w/ THE LANDLORD . INSTALL TEMPORARY PROTECTED MEANS OF EGRESS, LIGHTING AND SAFETY DEVICES IN ACCORDANCE WITH ALL w/ AUTHORITIES HAVING JURISDICTION, BUILDING REGULATIONS AND LANDLORD REQUIREMENTS.

H. PATCH OR REPAIR EXISTING FLOOR SLAB, DEMISING WALLS AND ROOFING AFTER COMPLETION OF ALL DEMOLITION AND PRIOR TO THE COMMENCEMENT OF NEW CONSTRUCTION. COORDINATE WITH LANDLORD PRIOR TO PERFORMING ANY ROOF WORK. PATCH, REPAIR AND LEVEL EXISTING FLOOR SLAB AND INFORM THE P.M. OF ANY SEVERE IRREGULARITIES IN EXISTING SLAB IMMEDIATELY.

I. COVER ANY RETURN AIR OPENINGS PRIOR TO DEMOLITION.

J. ALL REUSED EQUIPMENT AND UTILITIES ARE TO BE REFURBISHED TO "LIKE NEW" CONDITION.

K. EXERCISE EXTREME CARE DURING DEMOLITION SO AS NOT TO DAMAGE OR DISRUPT UTILITIES OR SPRINKLER LINES WHICH ARE NOT TO BE RELOCATED AND PASS THROUGH THE SPACE TO SERVE ADJACENT SPACES OR OTHER TENANTS. G.C. WILL BEAR SOLE RESPONSIBILITY OF ANY SUCH DISRUPTION OR DAMAGE.

L. REMOVE EXISTING PLUMBING FIXTURES INCLUDING TOILETS, LAVATORIES AND DRINKING FOUNTAINS. REUSE WATER AND SANITARY LINES ASSOCIATED WITH EXISTING FIXTURE FOR CONNECTION OF NEW TOILET, LAVATORY AND DRINKING FOUNTAIN, WHERE APPLICABLE.

M. COORDINATE THE REMOVAL, DISPOSAL AND/OR RETURN OF EXISTING SECURITY SYSTEMS (WHERE APPLICABLE) WITH P.M. PRIOR TO ITS REMOVAL. FAILURE TO DO SUCH COORDINATION WILL RESULT IN G.C. MONETARY FINE IN THE EQUIVALENT OF THE COST OF REPLACEMENT VALUE OF THE EXISTING SECURITY SYSTEM.

N. NOTIFY P.M. IMMEDIATELY OF ANY SEVERE DISCREPANCIES OR IRREGULARITIES DISCOVERED DURING DEMOLITION WHICH MAY AFFECT THE CURRENT STORE DESIGN. PAY SPECIAL ATTENTION TO AVAILABLE HEIGHT FOR INTENDED CEILING ELEVATION, MECHANICAL DUCTWORK, RECESSED LIGHTING AND ACCESS TO SIGNAGE.

O. ALL DEMOLITION WORK SHOWN ON PLAN IS SUBJECT TO REVIEW AND APPROVAL BY LANDLORD'S REPRESENTATIVES. VERIFY ANY DEMOLITION WORK REQUIRED BY LANDLORD THAT IS NOT SHOWN ON PLANS OR THAT MAY REQUIRE THE USE OF LANDLORD APPROVED CONTRACTORS.

HOLLISTER
CALIFORNIA

ABERCROMBIE & FITCH CO.
6301 FITCH PATH
NEW ALBANY, OHIO 43054
614-283-6500

SHREMSHOCK
Shremshock Architecture, Inc.
7775 Walton Parkway Ste. 250 New Albany, OH 43054
t: 614.545.4500 | f: 614.545.4555
Timothy J. Shremshock, Architect
info@shremshock.com
www.shremshock.com

THE ARCHITECT / ENGINEER ASSUMES NO RESPONSIBILITY OR LIABILITY FOR THE USE OF THESE PLANS FOR ANY PROJECT OTHER THAN SPECIFICALLY AUTHORIZED BY THEM AND SIGNED AND SEALED FOR SUCH SPECIFIC LOCATION IN THE STATE INDICATED. ANY UNAUTHORIZED USE OF THIS SEAL THIS BUILDING USE IS ONLY APPLICABLE IN AREAS MEETING THE STATED DESIGN CRITERIA.

THE AVENUE OF MURFREESBORO

2615 MEDICAL CENTER PARKWAY
MURFREESBORO, TN 37129
STORE #3684

Project No.:	260356
Drawn By:	JPS
Date	Issue
10-12-2026	BID SET

DEMOLITION & EXISTING CONDITIONS CEILING PLAN

A1.01

Plot date: OCT 13 2025

TEMPORARY BARRICADE NOTES

1. GENERAL CONTRACTOR TO FURNISH AND CONSTRUCT A TEMPORARY BARRICADE(S) OF 3-5/8" METAL STUDS @ 24" O.C. WITH ONE LAYER OF 5/8" GWB (MALL SIDE) TAPED, SPACKLED AND SANDED SMOOTH. INSTALL A GWB BACK TO MALL BULKHEAD TO CREATE DUST-PROOF CONDITION. BARRICADES ARE TO BE ADEQUATELY SECURED AND BRACED TO MALL BULKHEAD FRAMING FOR LATERAL STABILITY AND MUST BE STRUCTURALLY SOUND
NOTE: FOR EXTERIOR LOCATIONS (EXPOSED TO WEATHER) G.C. TO SUPPLY AND INSTALL 5/8" EXTERIOR GRADE CDX PLYWOOD ON VERTICAL AND HORIZONTAL SURFACES (TO REPLACE GYPSUM BOARD).

2. PAINT - ONE COAT PRIMER AND TWO COATS (P-13)

3. G.C. TO COORDINATE INSTALLATION OF GRAPHIC WITH OWNER'S VENDOR

4. G.C. IS RESPONSIBLE FOR MAINTAINING BARRICADE DURING CONSTRUCTION.

5. G.C. TO CONSULT WITH MALL REPRESENTATIVE FOR HOURS IN WHICH WORK ON BARRICADE CAN OCCUR.

6. REMOVE BARRICADE WHEN 100% OF STOREFRONT IS COMPLETE OR A MINIMUM OF TWO NIGHTS PRIOR TO OPENING. CARE IS TO BE TAKEN WHEN DISASSEMBLING AND REMOVING BARRICADE. PAPER WINDOWS WITH CRAFT CONSTRUCTION PAPER OVER GLAZING ONLY. TRIM 1/2" OFF EDGES AND TAPE CONTINOUSLY AROUND PERIMETER WITH WHITE TAPE.

7. G.C. TO RESTORE MALL FLOORING AND BULKHEAD TO A 'LIKE NEW' CONDITION AND FINISH.


8. ALL DELIVERIES TO SPACE DURING MALL HOURS SHALL BE MADE THROUGH SECONDARY EXIT. BARRICADE DOORS FOR FIXTURE & OVERSIZED MATERIAL DELIVERY AFTER MALL HOURS.

9. IF BARRICADE IS EXISTING, G.C. IS TO PREPARE FACE OF BARRICADE PER OWNERS STANDARDS FOR GRAPHIC INSTALLATION.


10. BARRICADE IS TO BE 100 % COMPLETE AND READY FOR OWNERS GRAPHICS TO BE INSTALLED NOT MORE THAN FOUR DAYS AFTER CONSTRUCTION START. G.C. TO CONTACT C.M. UPON COMPETION TO COORDINATE GRAPHIC INSTALL WITH GRAPHIC VENDOR.

NOTE:
BARRICADE ELEVATIONS A FOR REFERENCE ONLY. TEMPORARY PRE-MANUFACTURED EXTERIOR CONSTRUCTION BARRICADE SUPPLIED AND INSTALLED BY VENDOR. G.C. TO COORDINATE INSTALLATION WITH VENDOR AND LANDLORD PRIOR TO START OF CONSTRUCTION.


BOSTON BARRICADE IS BUILDING THE STOREFRONT PER RESPONSIBILITY SCHEDULE AND RON'S ESTIMATE. THIS SHEET CAN BE REMOVED.

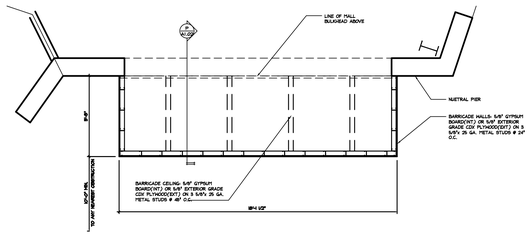


U A1.02 **BARRICADE PLAN**
SCALE: 1/4" = 1'-0"

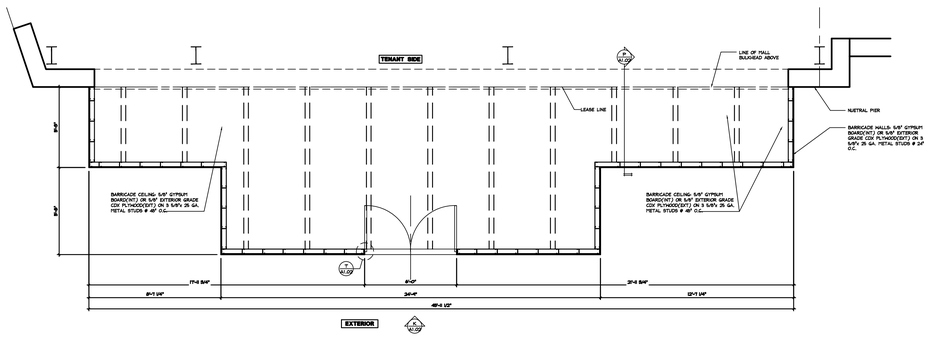


L A1.02 **BARRICADE PLAN**
SCALE: 1/4" = 1'-0"

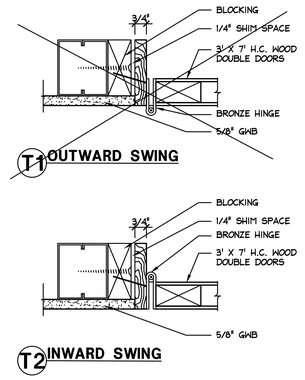


T A1.02 **BARRICADE DOOR DETAIL**
SCALE: 3" = 1'-0"

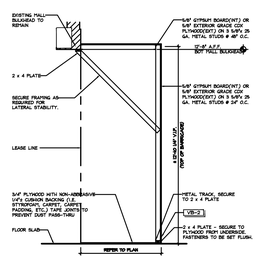


P A1.02 **BARRICADE SECTION**
SCALE: 1/4" = 1'-0"

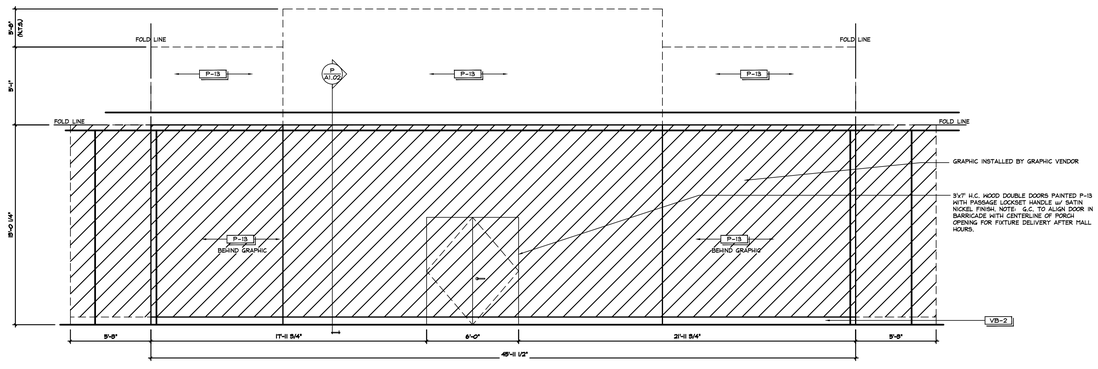

K A1.02 **BARRICADE ELEVATION**
SCALE: 1/4" = 1'-0"

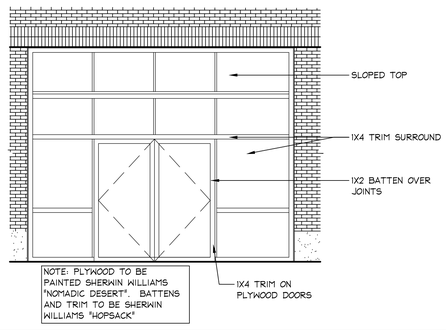

N A1.02 **BARRICADE ELEVATION**
SCALE: 1/4" = 1'-0"

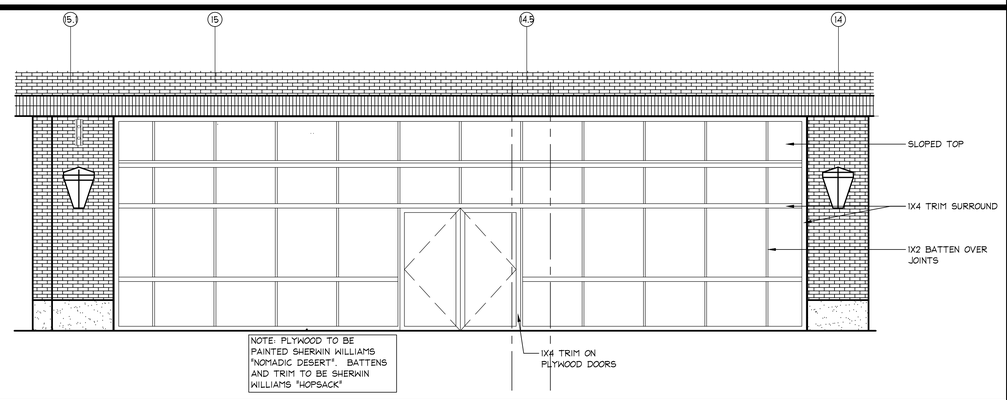

E A1.02 **BARRICADE ELEVATION**
SCALE: 1/4" = 1'-0"

HOLLISTER
CALIFORNIA
ABERCROMBIE & FITCH CO.
6301 FITCH PATH
NEW ALBANY, OHIO 43054
614-283-6500

SHREMSHOCK
Shremshock Architecture, Inc.
7775 Walton Parkway Ste. 250 New Albany, OH 43054
t: 614.545.4500 | f: 614.545.4555
Timothy J. Shremshock, Architect
info@shremshock.com
www.shremshock.com

THE ARCHITECT / ENGINEER ASSUMES NO RESPONSIBILITY OR LIABILITY FOR THE USE OF THESE PLANS FOR ANY PROJECT OTHER THAN SPECIFICALLY AUTHORIZED BY THEM AND SIGNED AND SEALED FOR SUCH SPECIFIC LOCATION IN THE STATE OF TENNESSEE. WITHOUT SUCH SIGNED AND SEAL, THIS BUILDING USE IS ONLY APPLICABLE IN AREAS MEETING THE STATED DESIGN CRITERIA.


THE AVENUE OF MURFREESBORO
2615 MEDICAL CENTER PARKWAY
MURFREESBORO, TN 37129
STORE #3684

Project No.:	260356
Drawn By:	CWH
Date	Issue
10-12-2026	BID SET

BARRICADE ELEVATIONS

A1.02

Plot date: OCT 13 2025

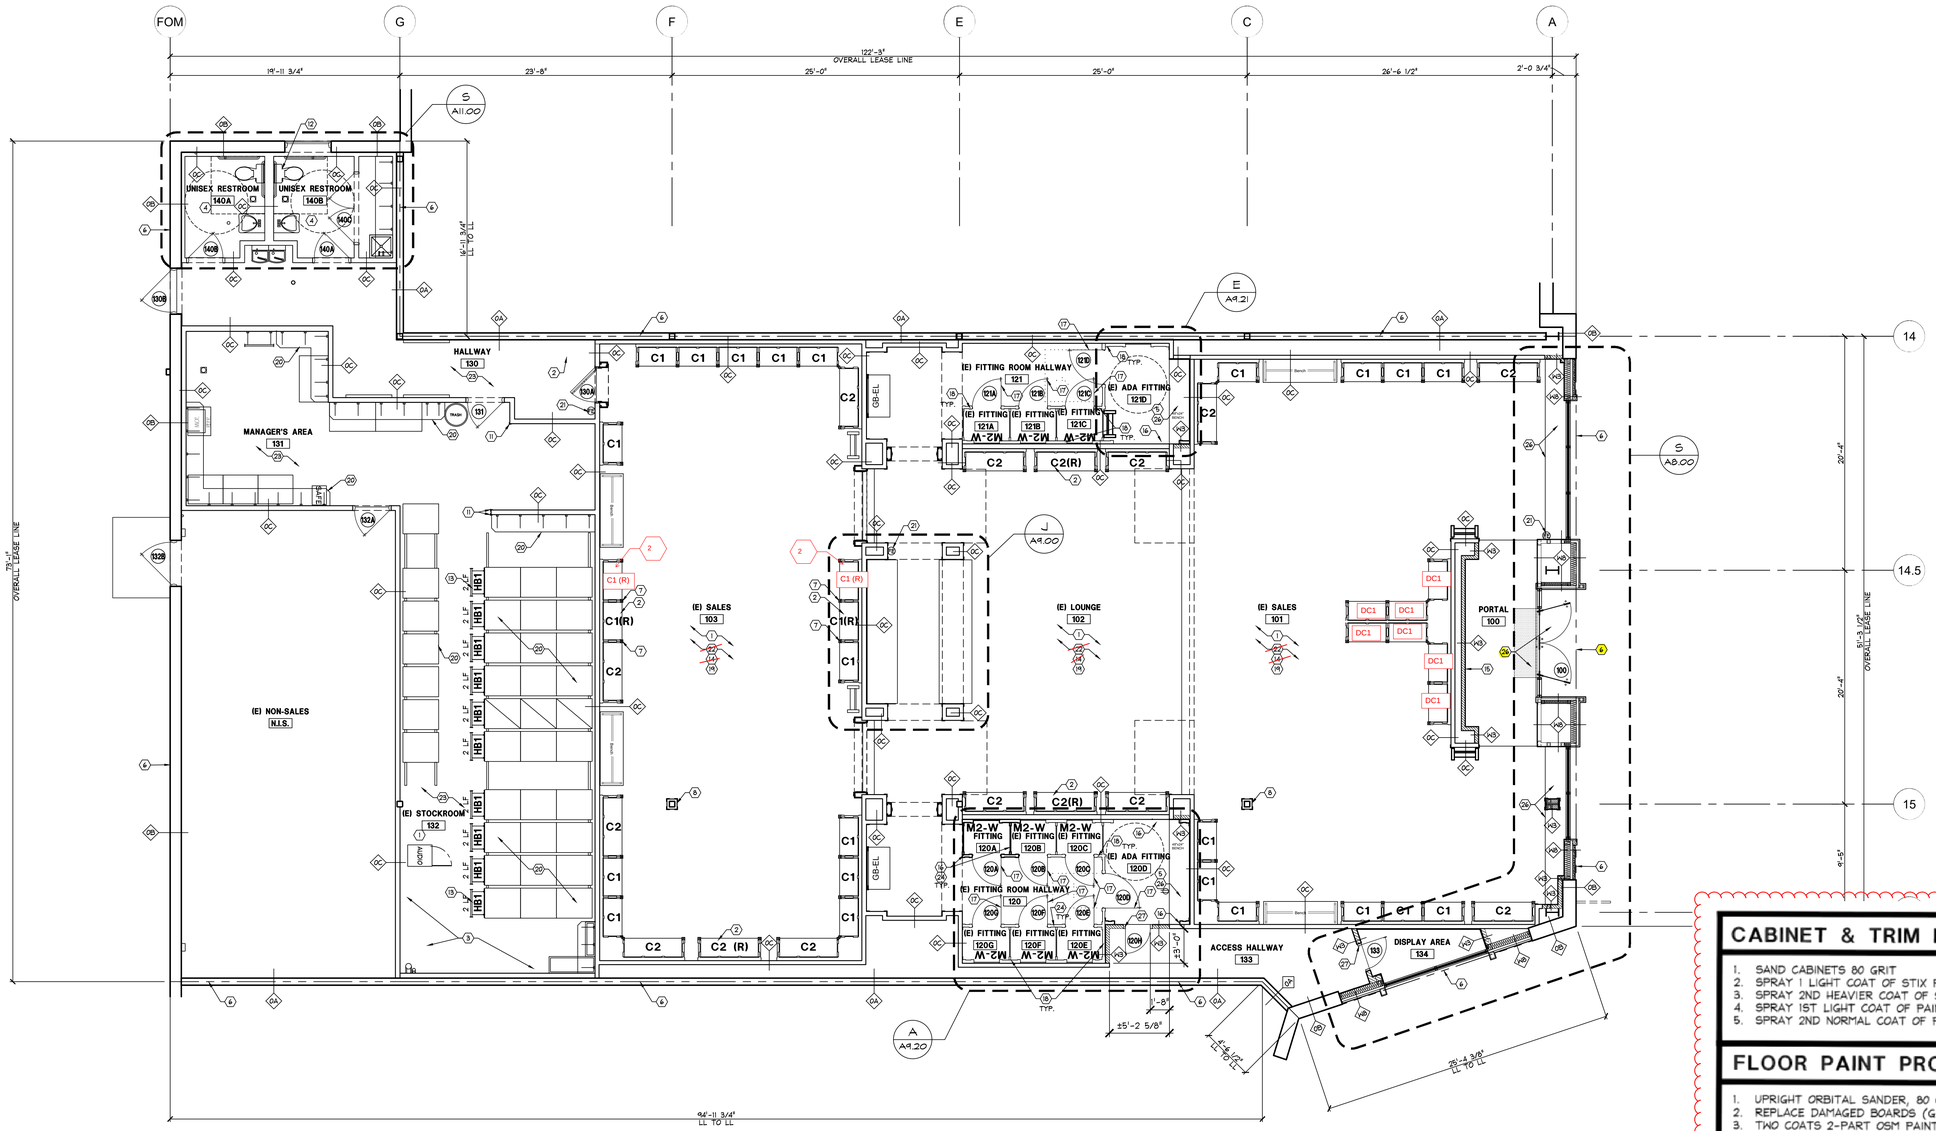

PULL FROM NEW HH REMODEL MASTER IN SUPPORTING DOCUMENTS FOLDER PROVIDED

CONSTRUCTION PLAN

SCALE: 3/16"=1'-0"

SYMBOL LEGEND

- ### — DOOR TYPE, REFER TO DOOR SCHEDULE ON A0.30
- XX — WALL TYPE, REFER TO WALL LEGEND THIS SHEET

PARTITION NOTES

A. PATCH & REPAIR EXISTING PARTITIONS (WHERE APPLICABLE) TO LIKE NEW CONDITIONS TO RECEIVE NEW FINISHES

B. MAXIMUM UN-BRACED LENGTH VALUES BASED ON SSMA ESR#3064P

C. ALL STUDS TO BE CONVENTIONAL STRUCTURAL METAL FRAMING STUDS, GAUGE EQUIVALENT DRYWALL FRAMING WILL NOT BE ACCEPTED.

D. REFER TO K/A1.10 FOR STUD SIZE MATRIX.

STEEL THICKNESS TABLE

18mil = 25GA	33mil = 20GA (STRUCT)	68mil = 14GA
27mil = 22GA	43mil = 18GA	97mil = 12GA
30mil = 20GA (INT.)	54mil = 16GA	118mil = 10GA

PARTITION LEGEND

- 0A — (E) DEMISING/CORRIDOR WALL — PATCH & REPAIR (TENANT SIDE ONLY) TO PROVIDE COMPLETE SECURE ASSEMBLY FROM FLOOR TO DECK & MAINTAIN FIRE RATING (WHERE APPLICABLE).
- 0B — (E) EXTERIOR WALL — EXISTING WALL CONSTRUCTION TO REMAIN. G.C. TO PATCH & REPAIR AS REQUIRED
- 0C — (E) INTERIOR WALL — EXISTING INTERIOR PARTITION TO REMAIN. G.C. TO PATCH AND REPAIR AS REQUIRED. G.C. TO INSTALL 1-LAYER 5/8" TYPE 'X' G.W.B. ON SALES AREA SIDE.
- ~~W1 — 600S162 STL. STUDS @ 16"o.c. FROM FLOOR TO UNDERSIDE OF DECK w/ 1-LAYER 5/8" TYPE 'X' G.W.B. EACH EXPOSED SIDE TO DECK OR TO ADJACENT CEILING. PROVIDE DEFLECTION TRACK ASSEMBLY @ DECK/STRUCTURE. REFER TO DETAIL J/A1.10 (MAX. UNBRACED LENGTH = 24'-7") REFER TO DETAIL J/A1.10 AND STUD MATRIX ON A1.20~~
- W3 — 362S162 STL. STUDS @ 16"o.c. FROM FLOOR TO 6" ABOVE ADJACENT CEILING w/ 1-LAYER 5/8" TYPE 'X' G.W.B. ON SALES AREA SIDE. (MAX. UNBRACED LENGTH = 16'-7") REFER TO DETAIL A/A1.10. REFER TO STUD MATRIX ON SHEET A1.20
- ~~W4 — 362S162 STL. STUDS @ 16"o.c. FROM FLOOR TO 12'-0"AFF w/ 1-LAYER 5/8" TYPE 'X' G.W.B. ON DISPLAY SIDE. (MAX. UNBRACED LENGTH = 16'-7") PROVIDE BOX COLUMN @ END OF WALL TO STRUCTURE ABOVE. REFER TO DETAIL M/A1.10 AND STUD MATRIX ON SHEET A1.20~~
- ~~W5 — 362S162 STL. STUDS (REFER TO STUD MATRIX ON SHEET A1.20) @ 16" O.C. FROM FLOOR TO DECK ABOVE w/ 1-LAYER 5/8" TYPE 'X' G.W.B. FULL HEIGHT ON SALES SIDE WHERE APPLICABLE AND TO CEILING JOISTS ON FITTING ROOM SIDE~~
- ~~W6 — 362S162 @ 16"o.c. FROM FLOOR TO 10'-0" w/ 1-LAYER 5/8" TYPE 'X' G.W.B. EACH EXPOSED SIDE. PROVIDE 8"x18GA. BOX BEAM AT TOP OF WALL WHERE INDICATED. REFER TO DETAIL A/A1.10. (MAX. UNBRACED LENGTH = 16'-7") REFER TO STUD MATRIX ON SHEET A1.20~~
- W7 — 362S162 @ 16"o.c. FROM FLOOR TO 10'-0" w/ 1-LAYER 5/8" TYPE 'X' G.W.B. EACH EXPOSED SIDE. REFER TO DETAIL A/A1.10. (MAX. UNBRACED LENGTH = 16'-7"). REFER TO STUD MATRIX ON SHEET A1.20
- W8 — NEW FULL HEIGHT EXTERIOR WALL - REFER TO STOREFRONT AND STRUCTURAL SHEETS FOR FRAMING INFORMATION

CODED NOTES

1. PROTECT EXISTING FLOOR DURING CONSTRUCTION. IN-FILL FLOOR WHERE EXISTING CABINETS WERE REMOVED. REFER TO DEMOLITION PLAN AND A4.00.
2. NEW LOCATION FOR (R) EXISTING LOCKERS
3. EXISTING ELECTRICAL EQUIPMENT TO REMAIN, REFER TO ELECTRICAL SHEETS FOR ANY NEW WORK.
4. G.C. TO INSTALL NEW WATER CLOSET IN EXISTING LOCATION, ALL OTHER PLUMBING FIXTURES & ACCESSORIES TO REMAIN. G.C. TO DEEP CLEAN.
5. MODIFY FITTING ROOM AS REQUIRED FOR ADA COMPLIANCE. INSTALL NEW TRIM/BASE TO MATCH EXISTING AS INDICATED IN ENLARGED DETAILS.
6. LEASE LINE - COORDINATE ADJACENT FLOOR FINISH REQUIREMENTS w/ LANDLORD (WHERE APPLICABLE).
7. INSTALL NEW OWNER PROVIDED TRIM TO CONNECT RELOCATED CABINETRY TO EXISTING, MODIFY AS REQUIRED TO FIT FLUSH.
8. EXISTING COLUMN ENCLOSURE TO REMAIN, PAINT PER NEW FINISHES. SEE U/A10.00
9. ~~(SF-1) WAINSCOTING - TYPICAL AT LAVATORY, MOP SINK, WATER COOLER, HARDWARE BIN AND BAR BIN. (REFER TO DETAIL L/A11.00 AND FINISH SCHEDULE)~~
10. ~~(SF-5) WAINSCOTING - TYPICAL AT ALL NON-SALES WALLS EXCEPT AT (SF-1) AND ELECTRIC PANEL LOCATIONS. (REFER TO DETAIL M/A11.00 AND FINISH SCHEDULE).~~
11. CORNER GUARD (TYP. ALL HIGH TRAFFIC NON-SALES CORNERS) - REFER TO DETAIL G/A11.00.
12. NEW WATER CLOSET. REFER TO PLUMBING DRAWINGS
13. NEW MOBILE SHELVING SYSTEM ATTACHED TO EXISTING SYSTEM. MOVABLE & FIXED SECTIONS (REFER TO SHEET A11.10). LEVEL FLOOR SLAB UNDER FIXTURE AREA TO MAXIMUM TOLERANCE OF 1/8" IN 10'-0" (REFER TO SPECIFICATIONS).
14. RELOCATE TRIM AND CAPITALS TO CONNECT RELOCATED CABINETRY TO EXISTING. MODIFY AS REQUIRED TO FIT FLUSH. G.C. TO FIRST USE EXISTING TRIM AND CAPITALS PROVIDED ON-SITE. IF MORE ARE REQUIRED THEN ANF PM CAN COORDINATE WITH VENDOR.
15. G.C. TO IN-FILL VOID FROM PREVIOUS VIDEO WALL SYSTEM REMOVAL WITH NEW FRAMING AND GYP. BOARD TO ALIGN WITH EXISTING. INSTALL LAYER OF 5/8" FRT PLYWOOD OVER TOP OF GYP BOARD SMOOTH INSTALLATION OF SHIPLAP WALL FINISH. REMOVE AND REINSTALL CROWN ON THIS WALL.
16. PREFABRICATED FITTING ROOM SYSTEM, G.C. TO SUPPLY AND INSTALL TO MATCH EXISTING BUILD-OUT. REFER TO A0.10 FOR TRIM PROCUREMENT RESPONSIBILITY.
17. NEW FITTING ROOM DOORS INSTALLED IN EXISTING FITTING ROOM OPENING, SEE DOOR SCHEDULE.
18. EXISTING PREFABRICATED FITTING ROOM SYSTEM TO REMAIN, REPAIR / TOUCH-UP PAINT FINISH AS REQUIRED TO ACHIEVE LIKE NEW CONDITION.
19. REFER TO FLOORING AND CABINETRY PREP SPECIFICATIONS ON A0.04 & A0.05.
20. EXISTING STORAGE SHELVING TO REMAIN.
21. EXISTING FIRE EXTINGUISHER TO REMAIN
22. RELOCATED CABINETS & SHUTTERS ABOVE. ALL OTHER CABINETS ARE EXISTING TO REMAIN. ALL CABINETS TO RECEIVE NEW SHELVES, PROVIDED BY OWNER, INSTALLED BY G.C. G.C. TO PROVIDE, CUT & INSTALL MDO ON TOP OF SALES AREA CABINETS. SEE DETAIL A/A9.00. INSTALL NEW OWNER PROVIDED TRIM TO EXTEND TO WALL BEHIND CABINET.
23. EXISTING TILE FLOORING TO REMAIN. G.C. TO PATCH/IN-FILL MISSING TILES, COORDINATE WITH PM.
24. FITTING ROOM PARTITIONS - G.C. TO SUPPLY MATERIALS AND CUSTOM BUILD PARTITIONS. SEE DETAILS ON A9.20. REFER TO A0.10 FOR TRIM PROCUREMENT RESPONSIBILITY.
25. ~~NEW TRANSOM WINDOW CONSTRUCTION. G.C. TO STRIP EXISTING TRIM AND MODIFY AS REQUIRED TO FIT NEW FRAME. CASING, FRAME, & TRANSOM WILL BE OSM.~~
26. NEW FLOOR FINISH CHANGE WITH NO ELEVATION CHANGE.
27. REFER TO A0.30 FOR DOOR JAMB/HEADER DETAIL

CABINET & TRIM PAINT PREP

REFER TO SPECIFICATIONS

1. SAND CABINETS 80 GRIT
2. SPRAY 1 LIGHT COAT OF STIX PRIMER - LET DRY 8 HOURS
3. SPRAY 2ND HEAVIER COAT OF STIX PRIMER - LET DRY 24 HOURS
4. SPRAY 1ST LIGHT COAT OF PAINT - LET DRY 8 HOURS
5. SPRAY 2ND NORMAL COAT OF PAINT

FLOOR PAINT PROCESS

REFER TO SPECIFICATIONS

1. UPRIGHT ORBITAL SANDER, 80 GRIT. SAND SEVERAL COATS DOWN.
2. REPLACE DAMAGED BOARDS (GET COUNT ON DAY ONE)
3. TWO COATS 2-PART OSM PAINT
4. 1/2 NAP ROLLER

GENERAL NOTES

A. ALL DIMENSIONS ARE FROM FACE OF GYPSUM BOARD TO FACE OF GYPSUM BOARD, UNLESS SPECIFICALLY NOTED OTHERWISE (U. N. O).

B. FOR CABINETS, PRE-MANUFACTURED TRIM ASSEMBLIES, AND SALES DOOR OPENING/TRANSOM ASSEMBLIES, & FITTING ROOM DOOR OPENING ASSEMBLIES, MILLWORK MANUFACTURER IS TO SUPPLY ALL SHOP DRAWINGS, MATERIAL SAMPLES, STRUCTURAL DETAILS AND FIRE RATING/FLAME SPREAD REPORTS AS REQUIRED TO LANDLORD, BUILDING CONTROL AND CONTRACTORS.

C. NO INTERIOR OR STOREFRONT CONSTRUCTION MAY BE SUSPENDED FROM METAL DECK, JOIST BRIDGING, JOIST CROSS-BRACING, PIPING, CONDUIT, DUCTWORK OR ANY OTHER NON-STRUCTURAL ITEM. DO NOT WELD, DRILL, SHOOT OR SCREW INTO STRUCTURAL STEEL OR JOISTS. USE CLAMPS, TIE-WIRE, THRU-BOLTS WITH WASHERS. REFER TO LANDLORD'S CONSTRUCTION MANUAL FOR METHODS OF ATTACHMENT TO STRUCTURE.

D. DO NOT USE COMBUSTIBLE MATERIALS SUCH AS WOOD BLOCKING, PVC, PLASTIC, ETC. IN CEILING PLENUM OR DEMISING WALL.

E. ADJUST SETTING BED UNDER EACH FLOOR MATERIAL TO ACHIEVE FLUSH TRANSITION.

F. ALL TEMPERATURE SENSORS & MOTION DETECTORS IN SALES AREA TO BE PAINTED TO MATCH ADJACENT SURFACE COLOR (EXCEPT DEVICE SENSORS).

G. ALL WET AREAS TO USE WATER RESISTANT "GREEN BOARD". AREAS TO INCLUDE RESTROOM, MOP SINK AND DRINKING FOUNTAIN AREAS.

H. ALL "IN-WALL" WOOD BLOCKING TO BE FIRE RETARDANT TREATED (FRT) AND BEAR THE MANUFACTURER'S STAMP OF VERIFICATION. WHERE AHJ DOES NOT ALLOW FRT WOOD BLOCKING IN WALL CAVITIES, USE 16 GA. SHEET METAL OR CODE APPROVED ALTERNATE BLOCKING MATERIALS U.N.O.

I. REFER TO SHEET A5.00 & A7.00 FOR MIRROR LOCATIONS REQUIRING IN-WALL BLOCKING.

J. REFER TO SHEET A1.10 TYPICAL PARTITION FRAMING DETAILS.

K. EXISTING WALLS TO REMAIN - PATCH & MATCH GYP. BD. TO PROVIDE SMOOTH FLUSH FINISH w/ ADJACENT SURFACES. EXTEND WALL/FURRING & GYP. BD. TO DECK (WHERE APPLICABLE)

L. GC TO PROVIDE AND INSTALL OUTLET. WHITE ON SALES FLOOR AND BLACK ON NAVAL CW WALL ONLY.
M. REFER TO FLOORING AND CABINETRY PREP SPECIFICATION ON A0.04 AND A0.05. REFER TO A0.40 AND A4.00 FOR NEW FINISHES.

HOLLISTER CALIFORNIA

ABERCROMBIE & FITCH CO.
6301 FITCH PATH
NEW ALBANY, OHIO 43054
614-283-6500

SHREMSHOCK
Shremshock Architecture, Inc.
7775 Walton Parkway Ste. 250 New Albany, OH 43054
t: 614 545 4500 | f: 614 545 4555
Timothy J. Shremshock, Architect
info@shremshock.com
www.shremshock.com

THE ARCHITECT / ENGINEER ASSUMES NO RESPONSIBILITY OR LIABILITY FOR THE USE OF THESE PLANS FOR ANY PROJECT OTHER THAN SPECIFICALLY AUTHORIZED BY THEM AND SIGNED AND SEALED FOR SUCH SPECIFIC LOCATION IN THE SEAL AND SIGNATURE BLOCK BELOW. WITHOUT SUCH SEAL, THIS BUILDING USE IS ONLY APPLICABLE IN AREAS MEETING THE STATED DESIGN CRITERIA.

THE AVENUE OF MURFREESBORO


2615 MEDICAL CENTER PARKWAY
MURFREESBORO, TN 37129
STORE #3684

Project No.:	260356
Drawn By:	CWH
Date	Issue
10-12-2026	BID SET

CONSTRUCTION PLAN

A2.00

Plot date: OCT 13 2025

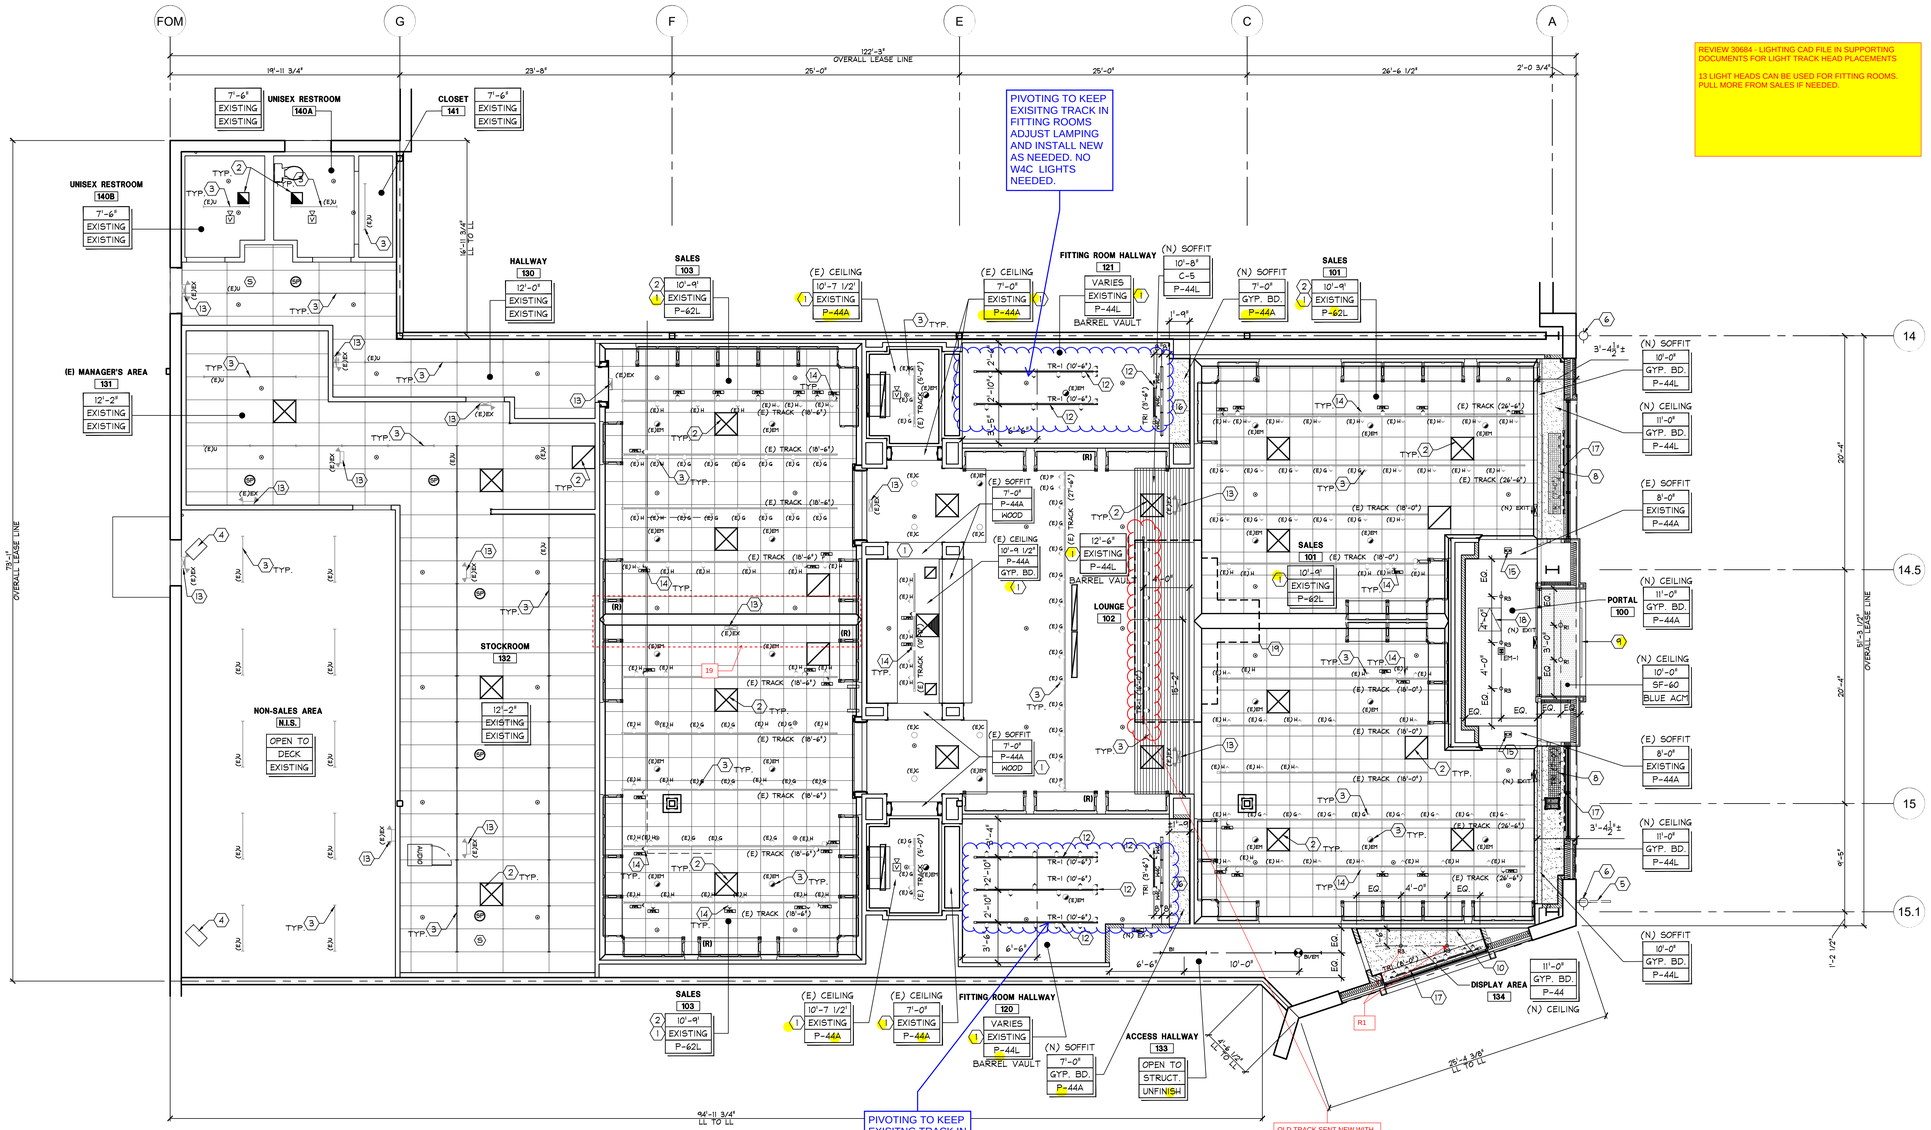

REVIEW 30684 - LIGHTING CAD FILE IN SUPPORTING DOCUMENTS FOR LIGHT TRACK HEAD PLACEMENTS

13 LIGHT HEADS CAN BE USED FOR FITTING ROOMS. PULL MORE FROM SALES IF NEEDED.

PIVOTING TO KEEP EXISITNG TRACK IN FITTING ROOMS ADJUST LAMPING AND INSTALL NEW AS NEEDED. NO W4C LIGHTS NEEDED.

PIVOTING TO KEEP EXISITNG TRACK IN FITTING ROOMS ADJUST LAMPING AND INSTALL NEW AS NEEDED. NO W4C LIGHTS NEEDED.

PIVOTING TO KEEP EXISITNG TRACK. ADJUST LAMPING AND INSTALL NEW AS NEEDED.

OLD TRACK SENT NEW WITH RELCOATED TRACK HEADS AS NEEDED

REFLECTED CEILING PLAN

SCALE: 3/16"=1'-0"

CODED NOTES

1. CLEAN, PREP AND PAINT EXISTING CEILINGS, SOFFITS, CROWN MOLDING AND TRIM ETC. CEILING CAN BE SPRAYED IN PLACE. G.C. TO COVER & PROTECT ALL CEILING DEVICES PRIOR TO PAINTING.
2. PAINT DIFFUSER UNIT TO MATCH ADJACENT CEILING.
3. EXISTING LIGHT FIXTURES TO REMAIN, G.C. TO ENSURE PROPER WORKING ORDER AND RE-LAMP AS REQUIRED.
4. (E) CEILING MOUNTED UNIT HEATERS. REFER TO MECHANICAL DRAWINGS.
5. NEW ILLUMINATED BLADE SIGN.
6. (E) LANDLORD'S WALL MOUNTED LIGHT FIXTURE TO REMAIN.
7. NOT USED.
8. 24" WIDE 'ULINE' MARKETING GRID w/ UNI-STRUT #P7008 1/4" CLAMP 12"o.c. & AT EACH END
9. NEW ILLUMINATED STOREFRONT SIGN.
10. NEW ILLUMINATED ~~STOREFRONT~~ SIGN BEHIND STOREFRONT GLAZING
11. ~~G.C. TO INSTALL SALVAGED CEILING TILE (AND NEW "LIKE FOR LIKE" TILE AS REQUIRED), ATTACH GRID SYSTEM TO EXISTING ADJACENT SYSTEM FOR A SEAMLESS TRANSITION.~~
12. NEW TRACK LIGHTING TRACK TO MATCH EXISTING TRACK; RELOCATE TRACK HEADS AS NEEDED, REFER TO ELECTRICAL DRAWINGS
13. EXISTING EMERGENCY EXIT / EGRESS LIGHTING TO REMAIN U.N.O., G.C. TO ENSURE PROPER WORKING ORDER.
14. NEW WALL WASH FIXTURE 'LWW' TO BE CIRCUITED WITH EXISTING TRACK FIXTURES. RE-USE EXISTING CIRCUITRY. VERIFY IN FIELD
15. RELOCATED SENSOURCE PEOPLE COUNTER LOCATION.
16. G.C. TO INSTALL NEW 5/8" GYPSUM BOARD OVER EXISTING FRAMING
17. CENTER TRACK LIGHTS ON STOREFRONT GLASS
18. G.C. TO PROVIDE AND INSTALL 24"x24" METAL CEILING ACCESS PANEL FOR SIGNAGE ACCESS. PAINT TO MATCH ADJACENT WALL CEILING. SEE DETAIL D/A10.00
19. APPROXIMATE AREA OF CEILING INFILL.

GENERAL NOTES

A. ALL DIMENSIONS ARE TO FACE OF GYPSUM WALL BOARD, UNLESS NOTED OTHERWISE. ALL CEILING HEIGHTS ARE ABOVE FINISH FLOOR (A.F.F.)

B. REFER TO SPECIFICATIONS AND FINISH SCHEDULE FOR PRODUCT AND INSTALLATION REQUIREMENTS.

C. REFER TO ELECTRICAL DRAWINGS FOR FIXTURE & LAMP SPECIFICATIONS.

D. ALL TEMPERATURE SENSORS & MOTION DETECTORS IN SALES AREA TO BE PAINTED TO MATCH ADJACENT SURFACE COLOR (EXCEPT SENSOR SURFACES)

E. ALL CEILINGS ARE GYPSUM BOARD UNLESS NOTED OTHERWISE. PATCH & REPAIR EXISTING SURFACES (WHERE APPLICABLE) TO PROVIDE SMOOTH FLUSH FINISH w/ ADJACENT SURFACES.

F. VERIFY ALL CLEAR HEIGHTS AT DEMOLITION.

G. PROVIDE ACCESS TO ANY LANDLORD AND TENANT EQUIPMENT, VALVES, DAMPERS, CONTROLS, CLEANOUTS, J-BOXES, ETC. LOCATED ABOVE GYPSUM BOARD CEILING AND ANY INACCESSIBLE AREAS AS REQUIRED. VERIFY/COORDINATE REQUIRED ACCESS PANEL LOCATIONS WITH THE TENANT'S ARCHITECT AND MALL OPERATIONS PRIOR TO START OF WORK.

H. CONFIRM WITH BUILDING OWNER FOR ACCEPTABLE METHODS OF ATTACHING TO BUILDING STRUCTURE.

I. REFER TO FF&E PLAN FOR TABLE AND MILLWORK MOUNTED LIGHTING FIXTURES, WHERE APPLICABLE.

L. CONTRACTOR TO RELOCATED FIXTURE AND SHALL AIM... IN ADJUSTABLE LUMINAIRES TO ACHIEVE DESIRED ILLUMINATION. SECURE LOCKING FITTINGS IN PLACE.

K. CENTER LIGHT FIXTURES IN ROOM - U.N.O.

L. LIGHT FIXTURE TO BE DUSTED AND WIPED DOWN.

HOLLISTER CALIFORNIA

ABERCROMBIE & FITCH CO.
6301 FITCH PATH
NEW ALBANY, OHIO 43054
614-283-6500

SHREMSHOCK
Shremshock Architecture, Inc.
7775 Walton Parkway Ste. 250 New Albany, OH 43054
t: 614 545 4500 | f: 614 545 4555
Timothy J. Shremshock, Architect
info@shremshock.com
www.shremshock.com

THE ARCHITECT / ENGINEER ASSUMES NO RESPONSIBILITY OR LIABILITY FOR THE USE OF THESE PLANS FOR ANY PROJECT OTHER THAN SPECIFICALLY AUTHORIZED BY THEM AND SIGNED AND SEALED FOR SUCH SPECIFIC LOCATION IN THE SEAL AND SIGNATURE BLOCK APPEARING ON THE SEAL. THIS BUILDING USE IS ONLY APPLICABLE IN AREAS MEETING THE STATED DESIGN CRITERIA.

THE AVENUE OF MURFREESBORO


2615 MEDICAL CENTER PARKWAY
MURFREESBORO, TN 37129
STORE #3684

Project No.:	260356
Drawn By:	CWH
Date	Issue
10-12-2026	BID SET


REFLECTED CEILING PLAN

A3.00


Plot date: OCT 13 2025

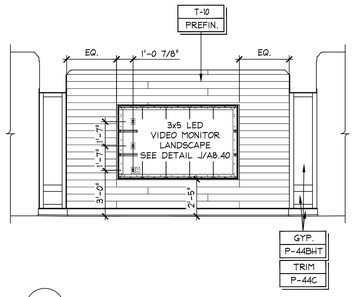


F **SALES**

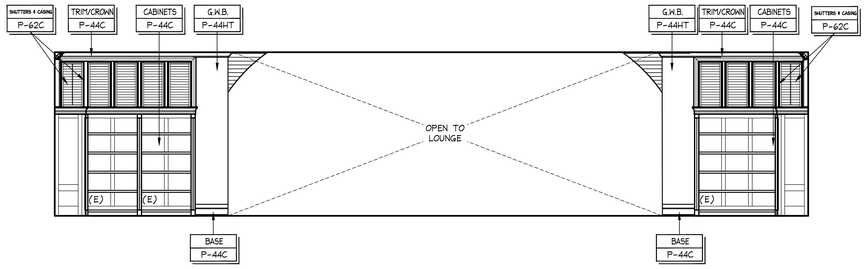


G **SALES**

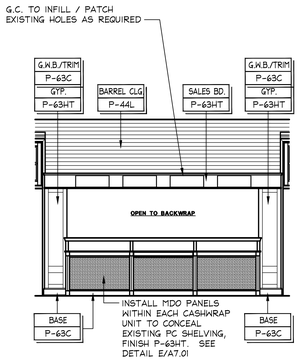

H **SALES (CASHWRAP)**

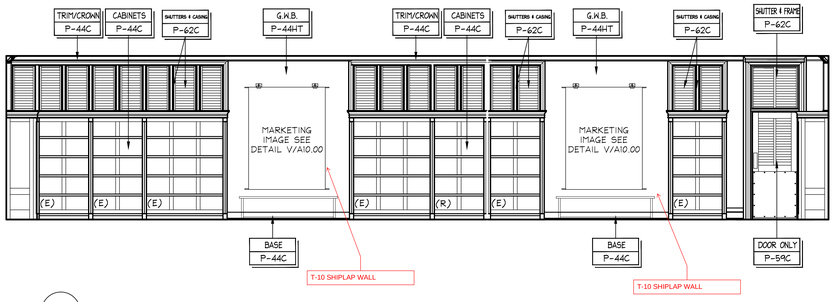

J **SALES**

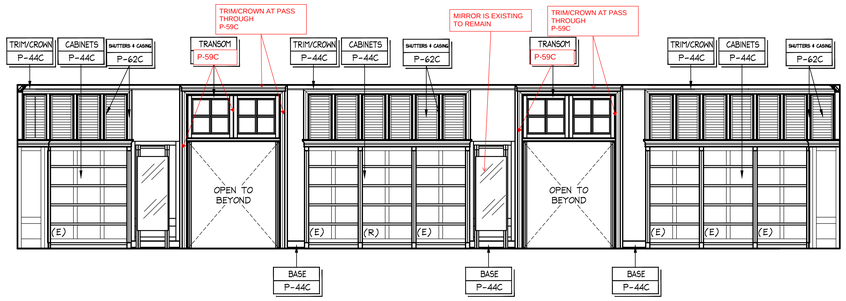

K **SALES**

GENERAL NOTES

A. REFER TO SPECIFICATIONS AND A0.40 FINISH SCHEDULE FOR PRODUCT AND INSTALLATION REQUIREMENTS.

B. REFER TO A2.00 CONSTRUCTION AND FINISH PLAN FOR ADDITIONAL INFORMATION.

C. SCRIBE WALL BASE TO TOP OF FINISHED FLOORING.

D. AFTER INSTALLATION OF ALL SALES TRIM, CASING, BASE, AND CROWN, FILL NAIL HOLES AND APPLY FINAL COAT.

HOLLISTER
CALIFORNIA

ABERCROMBIE & FITCH CO.
6301 FITCH PATH
NEW ALBANY, OHIO 43054
614-283-6500

SHREMSHOCK
Shremshock Architecture, Inc.
Timothy J. Shremshock, Architect
7775 Walton Parkway Ste. 250 New Albany, OH 43054
t: 614.545.4550 | f: 614.545.4555
info@shremshock.com
www.shremshock.com

THE ARCHITECT / ENGINEER ASSUMES NO RESPONSIBILITY OR LIABILITY FOR THE USE OF THESE PLANS FOR ANY PROJECT OTHER THAN SPECIFICALLY AUTHORIZED BY THEM AND SIGNED AND SEALED FOR SUCH SPECIFIC LOCATION IN THE STATE OF WHICH THEY ARE REGISTERED. WHERE SEAL THIS BUILDING USE IS ONLY APPLICABLE IN AREAS MEETING THE STATED DESIGN CRITERIA.

THE AVENUE OF MURFREESBORO


2615 MEDICAL CENTER PARKWAY
MURFREESBORO, TN 37129
STORE #3684

Project No.:	260356
Drawn By:	JPS
Date	Issue
10-12-2026	BID SET

INTERIOR ELEVATIONS


A7.01

Plot date: OCT 13 2025

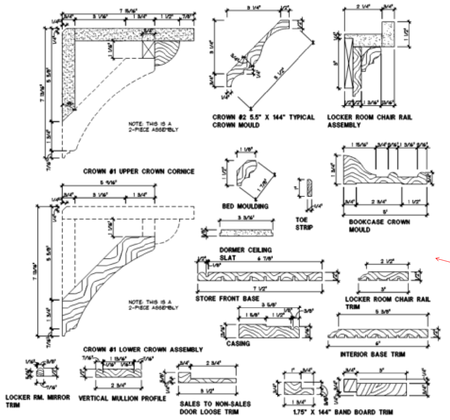


U A9.20 — **TRIM PROFILES (TO MATCH EXISTING)**
SCALE: 6" = 1'-0"


SEE SUPPORTING DOCUMENT FOR FILE

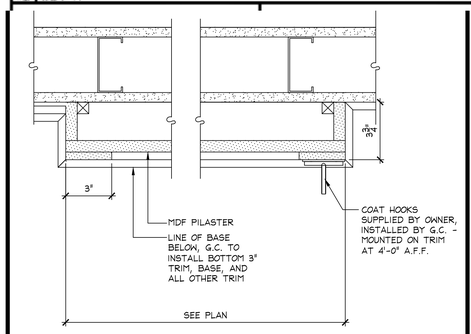


U A9.20 — **MIRROR END PANEL SECTION**
SCALE: 3" = 1'-0"

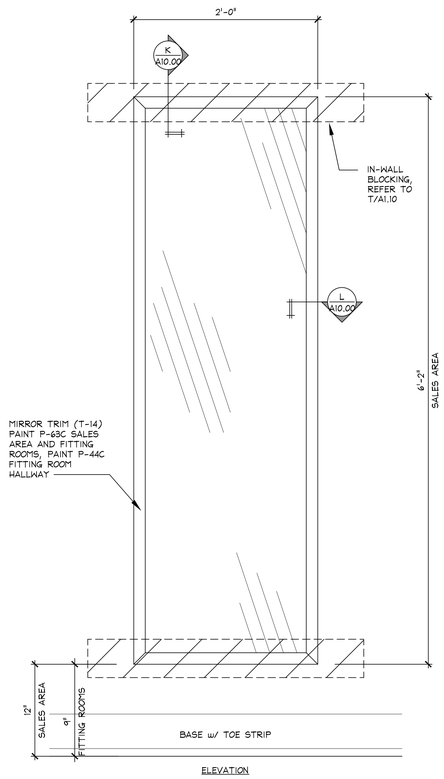


S A5.00 — **SALES AREA MIRROR (M2)**
SCALE: 1 1/2" = 1'-0"

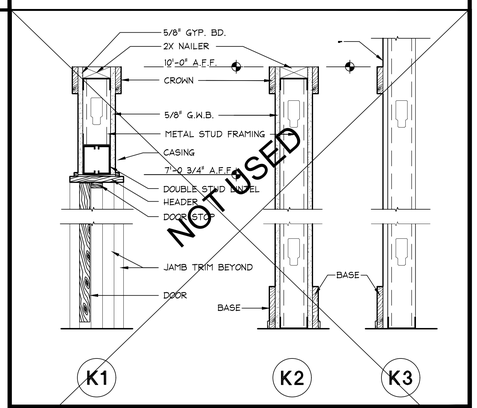

K A9.20 — **FITTING ROOM PARTITION DTLS.**
SCALE: 1 1/2" = 1'-0"

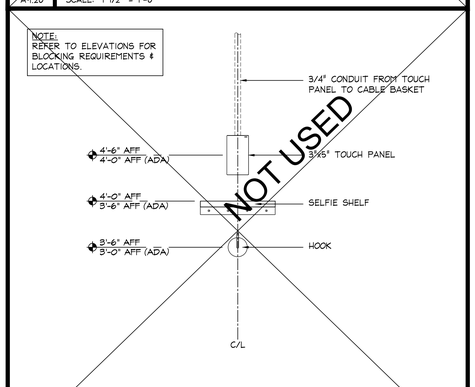


N A9.20 — **FITTING ROOM DEVICE LOCATIONS**
SCALE: 1 1/2" = 1'-0"

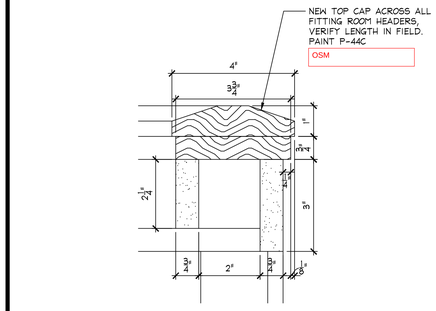


M A9.20 — **TOP CAP DETAIL**
SCALE: 6" = 1'-0"

ELEVATION CODED NOTES

1. WALL-MOUNTED MIRROR PROVIDED AND INSTALLED BY G.C. - SEE S/A9.20
2. ~~M.D.F. PILASTER BY G.C., G.C. TO INSTALL BOTTOM 3" TRIM BOARD AND BASE AND TOP CAP.~~
3. 3" WOOD TRIM
4. 1/2" MDO
5. MIRROR TRIM (T-14) PAINT P-63C SALES AREA AND FITTING ROOMS, PAINT P-44C FITTING ROOM HALLWAY
6. 5" TRIM
7. FITTING ROOM DOOR - REFER TO DOOR SCHEDULE
8. NEW CONTINUOUS TOP PIECE ACROSS ALL FITTING ROOMS - SEE DETAIL M/A9.20

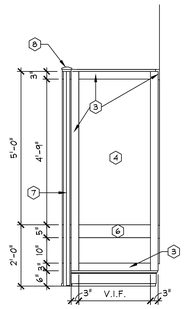

1 - NEW FITTING ROOM PANEL

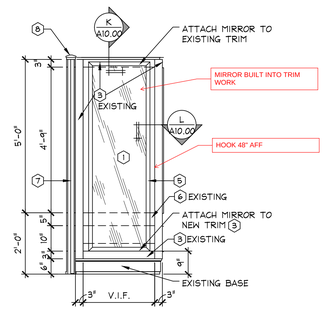


2 - NEW MIRROR AT EXISTING FITTING ROOM PANEL

H A9.20 — **FITTING ROOM ELEVATION**
SCALE: 1/2" = 1'-0"

GENERAL NOTES

A. FITTING ROOM ELEVATION MAY VARY, REFER TO PLAN.
B. MITER TRIM AT CORNERS - TYPICAL.
C. TRIM SHALL BE FASTENED w/ FINISHING NAILS, HOLES FILLED & SANDED PRIOR TO PAINT.

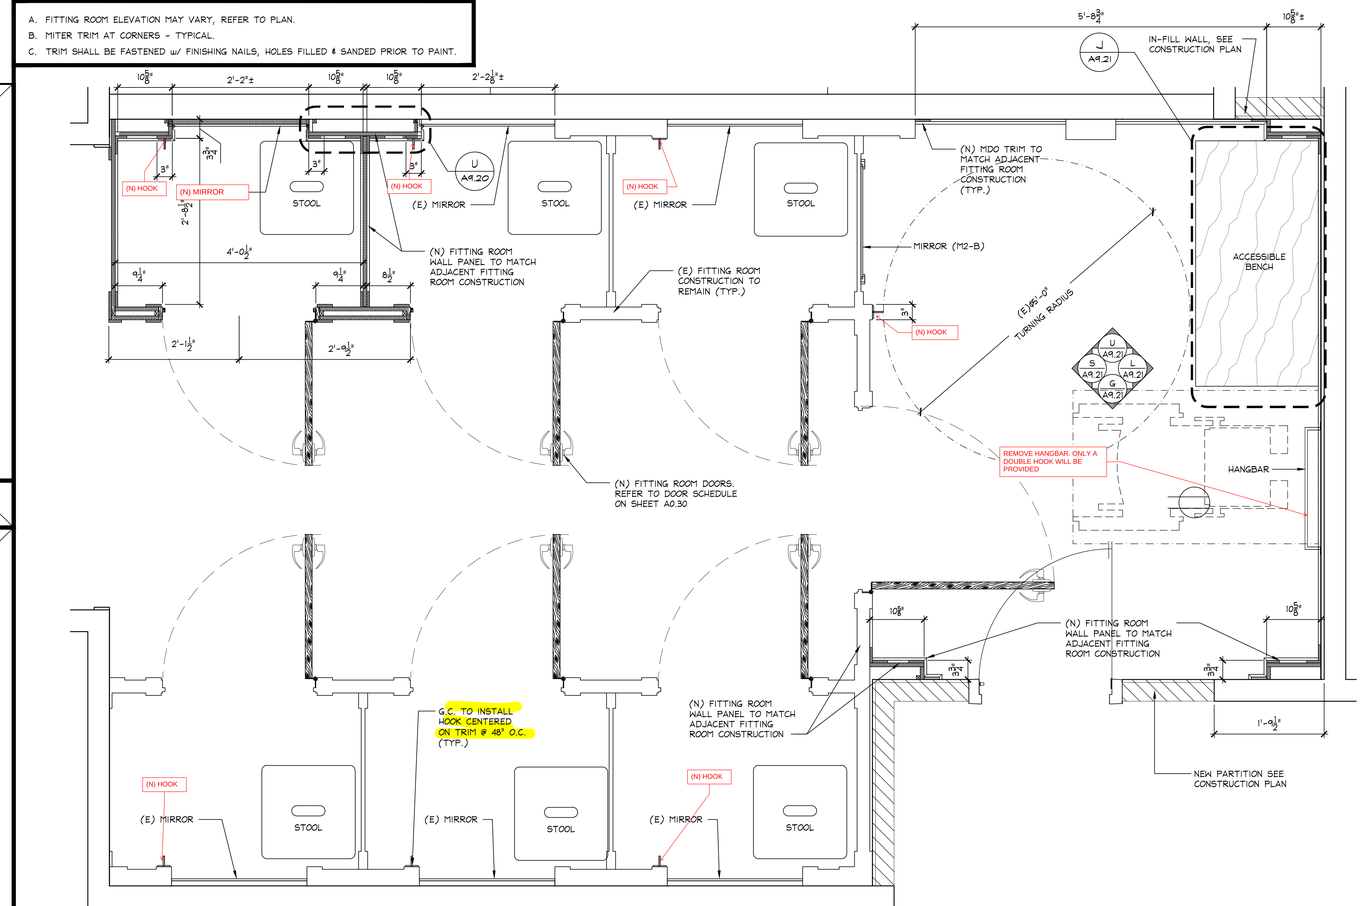

A A2.00 — **TYPICAL FITTING ROOM PLAN**
SCALE: 1" = 1'-0"

HOLLISTER CALIFORNIA

ABERCROMBIE & FITCH CO.
6301 FITCH PATH
NEW ALBANY, OHIO 43054
614-283-6500

SHREMSHOCK
Shremshock Architecture, Inc.
7775 Walton Parkway Ste. 250 New Albany, OH 43054
T: 614.545.4500 | F: 614.545.4555
Timothy J. Shremshock, Architect
info@shremshock.com
www.shremshock.com

THE ARCHITECT / ENGINEER ASSUMES NO RESPONSIBILITY OR LIABILITY FOR THE USE OF THESE PLANS FOR ANY PROJECT OTHER THAN SPECIFICALLY AUTHORIZED BY THEM AND SIGNED AND SEALED FOR SUCH SPECIFIC LOCATION IN THE STATE OF THE PROJECT. WITHOUT THEIR SIGNED AND SEAL, THIS BUILDING USE IS ONLY APPLICABLE IN AREAS MEETING THE STATED DESIGN CRITERIA.

THE AVENUE OF MURFREESBORO


2615 MEDICAL CENTER PARKWAY
MURFREESBORO, TN 37129
STORE #3684

Project No.:	260356
Drawn By:	XXX
Date	Issue
10-12-2026	BID SET


TYPICAL FITTING ROOM PLAN, ELEVATIONS & DETAILS

A9.20


Plot date: OCT 13 2025

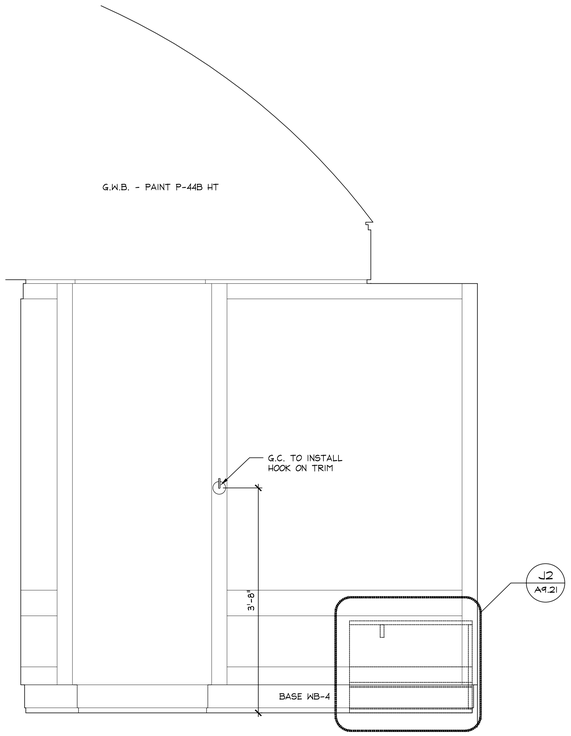


U ELEVATION
A9.21 SCALE: 1" = 1'-0"

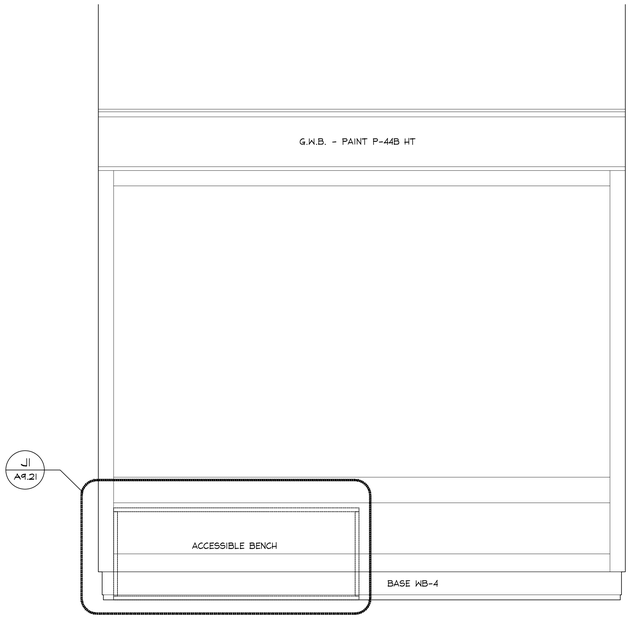

L ELEVATION
A9.21 SCALE: 1" = 1'-0"

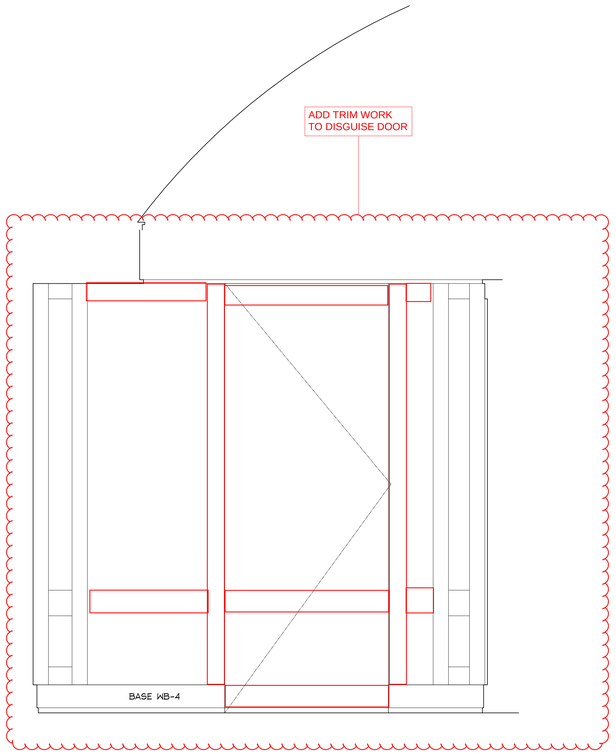


G ELEVATION
A9.21 SCALE: 1" = 1'-0"

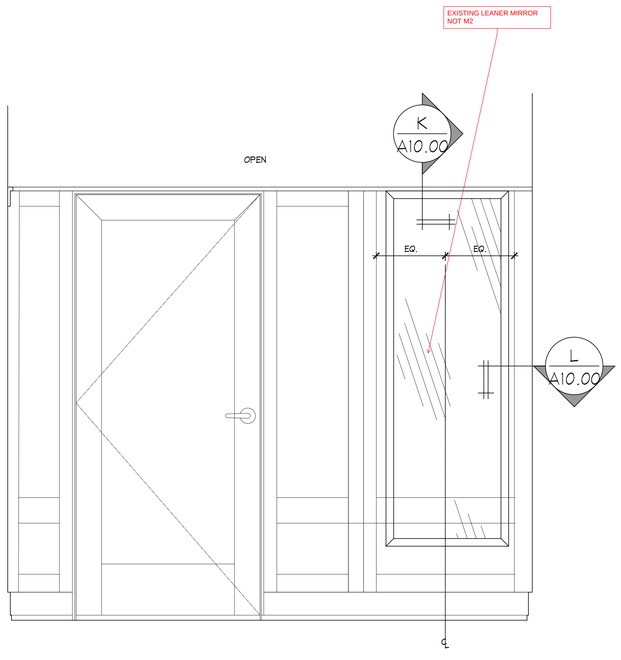

S ELEVATION
A9.21 SCALE: 1" = 1'-0"

NOTE:
A. ADA BENCH SENT PRE-FINISHED & ASSEMBLED.
B. MOUNTING HARDWARE TO BE SUPPLIED & INSTALLED BY G.C.
C. G.C. TO INSTALL ADA BENCH OPEN SIDE FACING OUT.

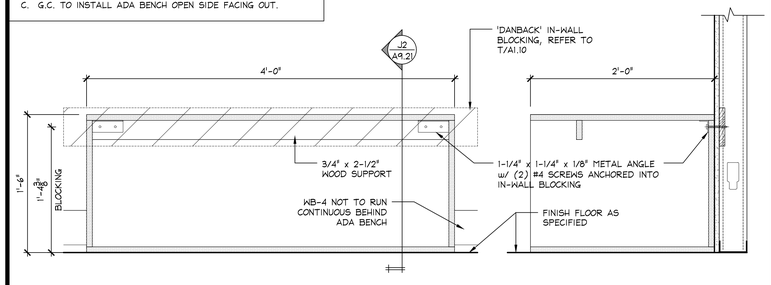


J1 ELEVATION

J2 SECTION

J ADA FITTING ROOM BENCH DETAILS
A9.21 SCALE: 1 1/2" = 1'-0"

GENERAL NOTES

A. FITTING ROOM ELEVATION MAY VARY, REFER TO PLAN.
B. MITER TRIM AT CORNERS - TYPICAL.

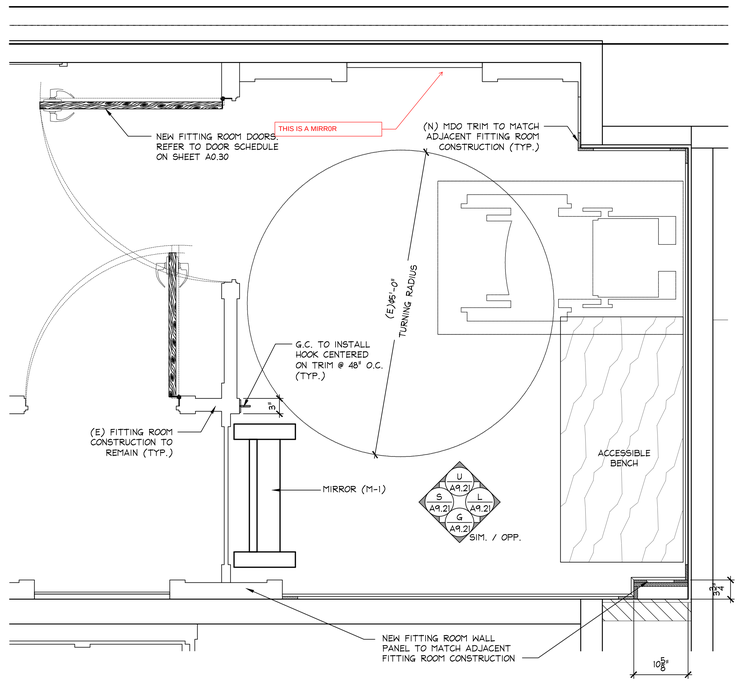

E TYPICAL ADA FITTING ROOM PLAN
A2.00 SCALE: 1" = 1'-0"

HOLLISTER CALIFORNIA

ABERCROMBIE & FITCH CO.
6301 FITCH PATH
NEW ALBANY, OHIO 43054
614-283-6500

SHREMSHOCK
Shremshock Architecture, Inc.
7775 Walton Parkway Ste. 250 New Albany, OH 43054
t: 614.545.4555 | f: 614.545.4555
Timothy J. Shremshock, Architect
info@shremshock.com
www.shremshock.com

THE ARCHITECT / ENGINEER ASSUMES NO RESPONSIBILITY OR LIABILITY FOR THE USE OF THESE PLANS FOR ANY PROJECT OTHER THAN SPECIFICALLY AUTHORIZED BY THEM AND SIGNED AND SEALED FOR SUCH SPECIFIC LOCATION IN THE PROJECT MANUAL. WHERE ARCHITECT'S SEAL APPEARS, THIS BUILDING USE IS ONLY APPLICABLE IN AREAS MEETING THE STATED DESIGN CRITERIA.

THE AVENUE OF MURFREESBORO


2615 MEDICAL CENTER PARKWAY
MURFREESBORO, TN 37129
STORE #3684

Project No.:	260356
Drawn By:	CWH
Date	Issue
10-12-2026	BID SET


TYPICAL ADA FITTING ROOM
PLAN, ELEVATIONS & DETAILS

A9.21


Plot date: OCT 13 2025

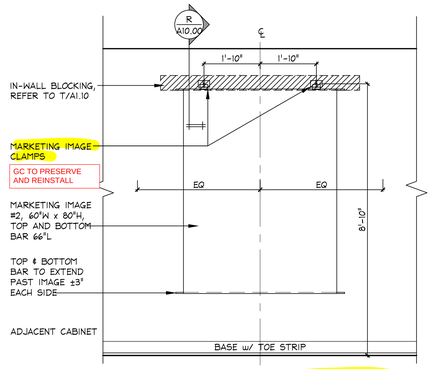


V A10.00 **MARKETING IMAGE ELEVATION**
SCALE: 1/2" = 1'-0"

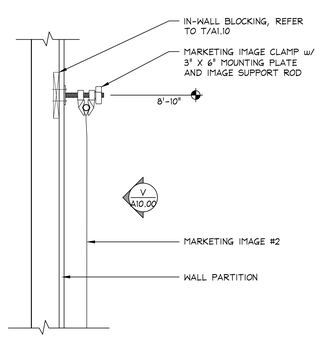


R A10.00 **MARKETING IMAGE CLAMP DETAIL**
SCALE: 1 1/2" = 1'-0"

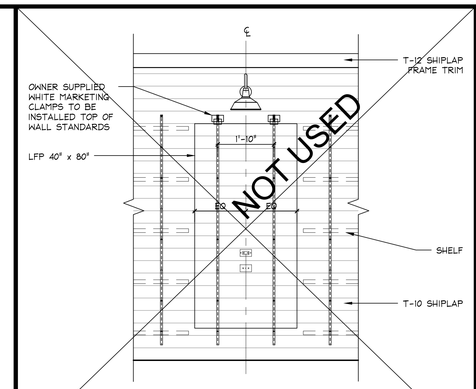


M A5.00 **40x80 MARKETING ELEVATION**
SCALE: 1/2" = 1'-0"

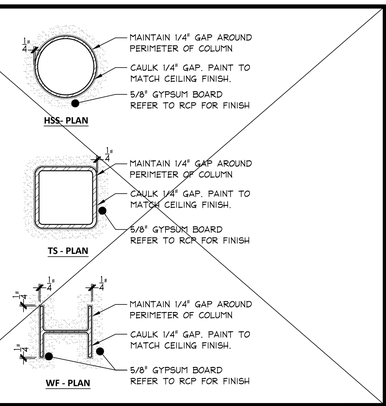


H A10.00 **CEILING DETAIL AT EXPOSED CO**
SCALE: 1" = 1'-0"

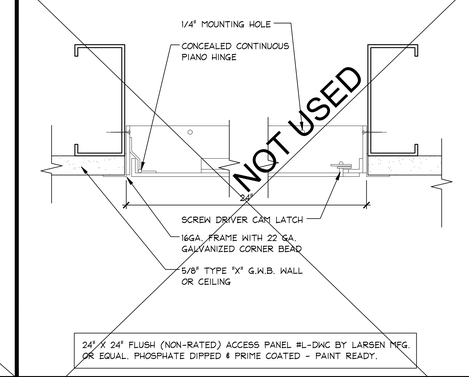


D A10.00 **ACCESS PANEL**
SCALE: 6" = 1'-0"

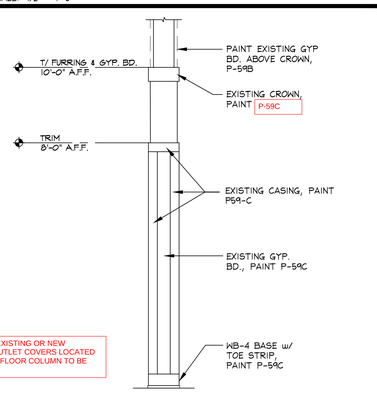


U A10.00 **HCO COLUMN ELEVATION**
SCALE: 1/2" = 1'-0"

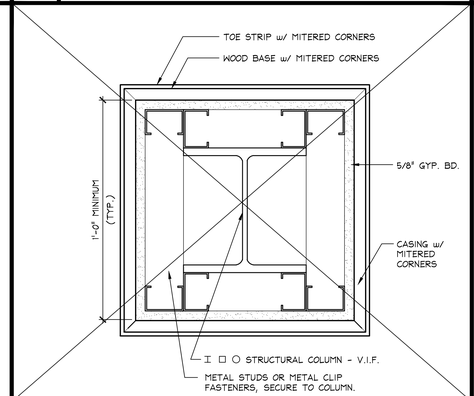


Q A10.00 **COLUMN DETAIL**
SCALE: 3" = 1'-0"

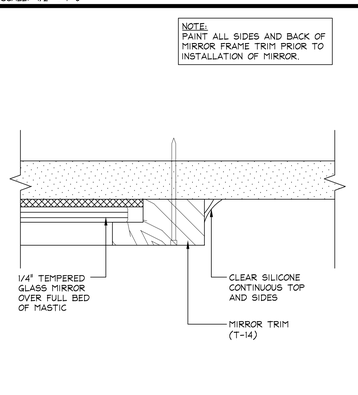


L A10.00 **MIRROR DETAIL (M2) - VERT.**
SCALE: FULL SIZE

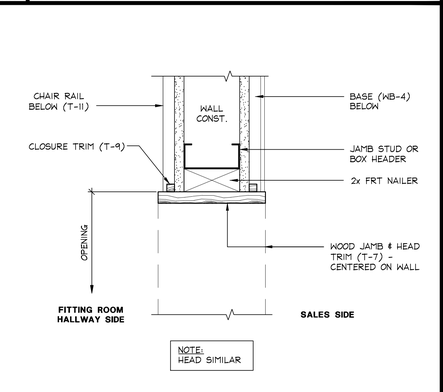


G A10.00 **CASED OPENING DETAIL @ PASS-THRU**
SCALE: 3" = 1'-0"

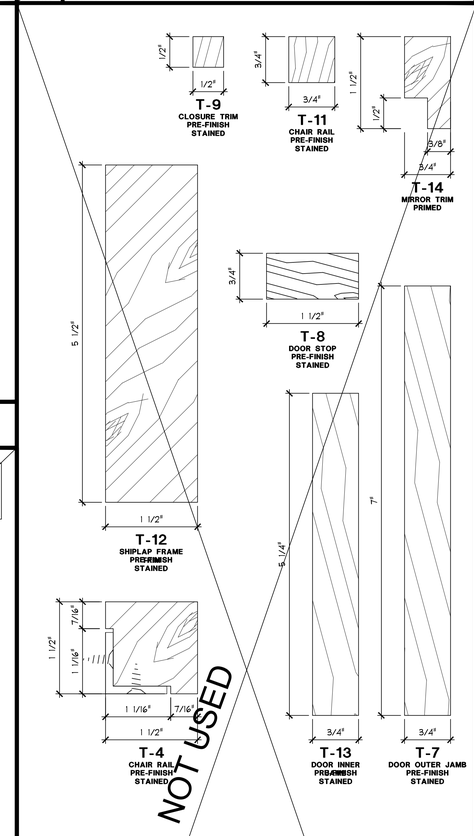


A A10.00 **TRIM PROFILES**
SCALE: 1'-0" = 1'-0"

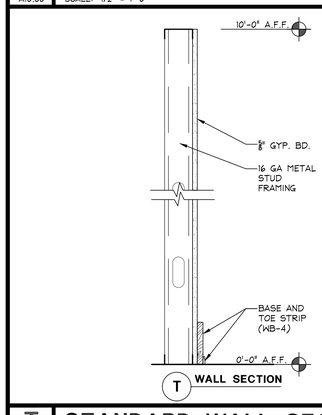


T A10.00 **STANDARD WALL SECTION**
SCALE: 1 1/2" = 1'-0"

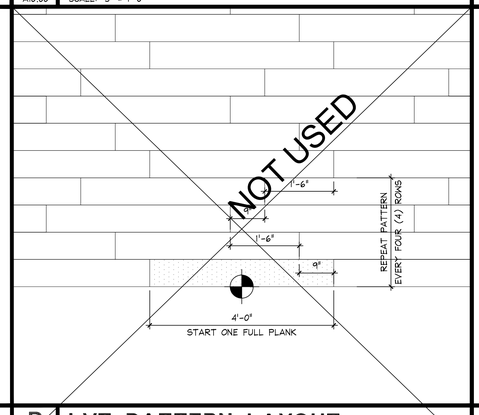


P A4.00 **LVT PATTERN LAYOUT**
SCALE: 3/4" = 1'-0"

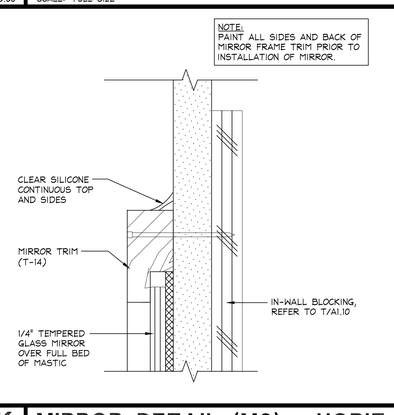


K A10.00 **MIRROR DETAIL (M2) - HORIZ.**
SCALE: FULL SIZE

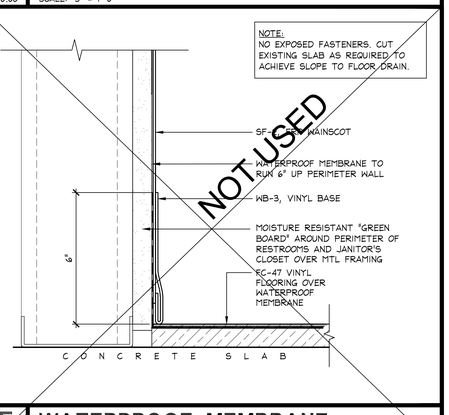


F A10.00 **WATERPROOF MEMBRANE**
SCALE: 6" = 1'-0"

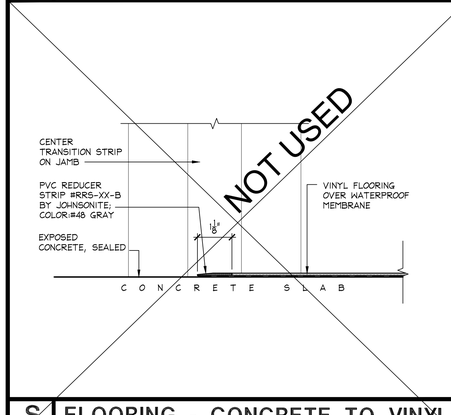


S A4.00 **FLOORING - CONCRETE TO VINYL**
SCALE: 6" = 1'-0"

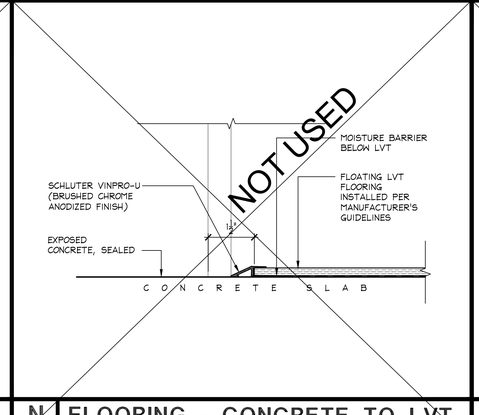

N A4.00 **FLOORING - CONCRETE TO LVT**
SCALE: 6" = 1'-0"

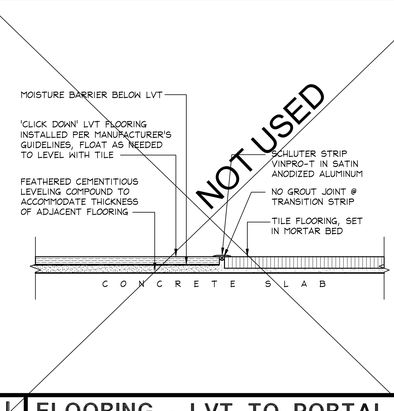

J A4.00 **FLOORING - LVT TO PORTAL TILE**
SCALE: 6" = 1'-0"

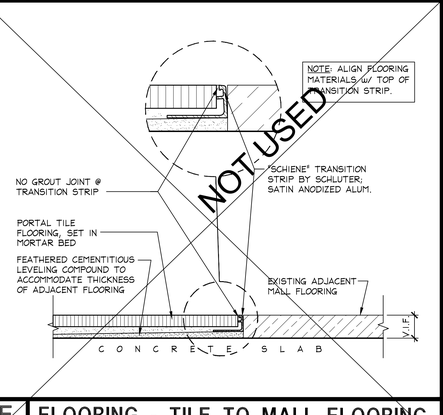

E A4.00 **FLOORING - TILE TO MALL FLOORING**
SCALE: 6" = 1'-0"

HOLLISTER
CALIFORNIA

ABERCROMBIE & FITCH CO.
6301 FITCH PATH
NEW ALBANY, OHIO 43054
614-283-6500

SHREMSHOCK

Shremshock Architecture, Inc.
7775 Walton Parkway Ste. 250 New Albany, OH 43054
t: 614 545 4500 | f: 614 545 4555

Timothy J. Shremshock, Architect
mail@shremshock.com
www.shremshock.com

THE ARCHITECT / ENGINEER ASSUMES NO RESPONSIBILITY OR LIABILITY FOR THE USE OF THESE PLANS FOR ANY PROJECT OTHER THAN SPECIFICALLY AUTHORIZED BY THEM AND SIGNED AND SEALED FOR SUCH SPECIFIC LOCATION IN THE SPACE PROVIDED ADJACENT TO THEIR SIGNATURE SEAL. THIS BUILDING USE IS ONLY APPLICABLE IN AREAS MEETING THE STATED DESIGN CRITERIA.

THE AVENUE OF MURFREESBORO

2615 MEDICAL CENTER PARKWAY
MURFREESBORO, TN 37129
STORE #3684

Project No.:	250356
Drawn By:	JPS
Date	Issue
10-12-2026	BID SET

MISCELLANEOUS SALES AREA DETAILS

A10.00

Plot date: OCT 13 2025

R NOT USED

E1.10 SCALE: NONE

ELECTRICAL DEVICE SCHEDULE

MARK	MANUFACTURER	MODEL	DESCRIPTION	WALLPLATE MANUFACTURER	WALLPLATE MODEL	WALLPLATE DESCRIPTION
DIM	CHESTERON	-	FITTING ROOM LIGHTING DIMMING PANEL	-	-	-

VERIFY ELECTRICAL DEVICE MODEL NUMBERS AND DESCRIPTIONS WITH HOLLISTER PROJECT MANAGER PRIOR TO ORDERING.

U NOT USED

E1.10 SCALE: NONE

Q OSM ELECTRICAL DEVICE SCHEDULE

E1.10 SCALE: NONE

TYPE	FIXTURE DESCRIPTION	FINISH	LAMP TYPE	DDS PART # (A&F ITEM ID)	LAMP WATTS/ TOTAL LAMP POWER	LAMPS / UNIT	MAX. FIX. WATT.	VOLTAGE	MANUFACTURER: CATALOGUE # (INTEGRAL / REMOTE DRIVER)	A&F ITEM ID	NOTES / MODIFICATIONS
B1	SURFACE MOUNTED NOMINAL 4'-0" LONG STRIP LIGHT WITH INTEGRATED 3000K LED, STEEL HOUSING AND LENS AT NON-SALES AREAS.	WHITE	N/A	N/A	N/A	N/A	20.3 W	120 V	LITHONIA: CLX L48 3000LM SEF RDL MVOLT GZ10 **30K** 90CRI WH (INTEGRAL DRIVER)	74544 **NOTE:** ATYPICAL COLOR TEMPERATURE DUE TO LANDLORD REQUIREMENTS.	U.L. APPROVED.
B1/EM	SURFACE MOUNTED NOMINAL 4'-0" LONG STRIP LIGHT WITH INTEGRATED 3000K LED, STEEL HOUSING, LENS AND EMERGENCY BATTERY PACK AT NON-SALES AREAS.	WHITE	N/A	N/A	N/A	N/A	20.3 W	120 V	LITHONIA: CLX L48 3000LM SEF RDL MVOLT GZ10 **30K** 90CRI E10WLCP SPD WH (INTEGRAL DRIVER & BATTERY)	74740 **NOTE:** ATYPICAL COLOR TEMPERATURE DUE TO LANDLORD REQUIREMENTS.	U.L. APPROVED.
TR1	SURFACE MOUNTED TO UNISTRUT SINGLE CIRCUIT EXTRUDED ALUMINUM LIGHTING TRACK WITH ALL NECESSARY MOUNTING HARDWARE, FEEDS AND CONNECTORS	WHITE	N/A	N/A	N/A	N/A	N/A	120 V	LIGHTOLIER: 6008NWH (8FT TRACK+DEAD END) LIGHTOLIER: 6048NWH (LIVE END FEED) LIGHTOLIER: 6048NWH (COUPLER)	76151 (8FT TRACK) 76152 (FEED) 76153 (COUPLER)	U.L. APPROVED. REFER TO ARCHITECTURAL DRAWINGS FOR LENGTHS.
T3	TRACK MOUNTED SINGLE CIRCUIT INTEGRATED 3000K LED ADJUSTABLE ACCENT LIGHT WITH 35° BEAMSPREAD, ADJUSTABLE TILT, AND 360 DEGREE ROTATION. 90 CRI.	WHITE	N/A	N/A	N/A	N/A	13.5 W	120 V	GE: LTC-ID-A-1-10-WF-9-30-P-Q-L2-WHITE (LIGHTOLIER ADAPTER)	76149	U.L. APPROVED
R3	FULLY RECESSED NOMINAL 3 1/2" DIAMETER ROUND DOWNLIGHT WITH 75° VERY WIDE FLOOD BEAMSPREAD AND INTEGRATED 3000K LED. (DIMMABLE). 83 CRI.	WHITE	N/A	N/A	N/A	N/A	23 W	120 V	AMERLUX: HDL-HP-R-NC-A17-T-23-120-LE/TE (HOUSING) AMERLUX: HDL-HP-RLD-A17-T-MWW-7SSAT-309- (TRIM) (INTEGRAL NON-DIM DRIVER)	76126: HOUSING 76627: TRIM	UL APPROVED.
W4C	WALL/CEILING MOUNTED NOMINAL 24" 3000K LINEAR LED, ALUMINUM HOUSING FLAT ACRYLIC LENS. 80 CRI	WHITE	N/A	N/A	12 W	N/A	12 W	120 V	REXEL ML2F-930	TBD	U.L. APPROVED.
R1	JUNO WF4 SWW5 90CRI MB MR (27K-30K-35K-40K-50K) BLACK. WET RATED. SET TO 30K TO ALIGN WITH LANDLORD CRITERIA.	BLACK	NA	NA	NA	NA	15 W	120v	JUNO WT4 SWW5	74266	U.L. APPROVED.
EXIT	LITHONIA LIGHTING LRP SERIES (FORMERLY PRECISE COLLECTION, NOW SIGNATURE SERIES). RECESSED CEILING MOUNTED, SINGLE FACE. CLEAR ACRYLIC EDGE-LIT LED EXIT SIGN WITH RED LETTERING, WHITE HOUSING, AND MAINTENANCE-FREE NICKEL CADMIUM BATTERY BACKUP.	CLEAR PANELURED LETTERS, WHITE HOUSING	LED	N/A	N/A	N/A	3.2	120 V	LITHONIA LIGHTING LRP SERIES (FORMERLY PRECISE COLLECTION, NOW SIGNATURE SERIES): LRP-W-1-RC-120/277-EL N-EM REFER TO PLAN FOR DIRECTIONAL INDICATORS.	N/A – PUBLIC-FACING EXIT SIGN PER LANDLORD REQUIREMENTS.	U.L. APPROVED.
EX-3	SELF CONTAINED EMERGENCY EXIT SIGN (SINGLE/DOUBLE FACE AND ARROW DIRECTION TO BE VERIFIED IN FIELD) WITH MAINTENANCE-FREE NICKEL CADMIUM BATTERIES AND RED LETTERS.	WHITE	N/A	N/A	N/A	N/A	4 W	120 V	BEST: EZXTEU-2-R-W-EM	76932	U.L. APPROVED.
EM-1	SELF CONTAINED, RECESSED CEILING MOUNTED, RETRACTABLE DOUBLE HEAD ADJUSTABLE LED EMERGENCY FIXTURE WITH LAMP HEADS CONCEALED BEHIND DOOR WHEN NOT IN USE WITH MAINTENANCE-FREE NICKEL METAL HYDRIDE BATTERY BACKUP.	WHITE	LED	N/A	N/A	N/A	9 W	120 V	EVENLITE: APAL-WH-UI	TBD	U.L. APPROVED.
WWL	6" TRACK MOUNTED WALL WASH FIXTURE WITH INTEGRAL LED PROVIDING 1600 LUMENS AT 3000K, 90+ CRI	WHITE/BLACK	LED	N/A	N/A	N/A	17 W	120 V	LUMENTURE: TWW160-30H-1600-W/B-H	N/A	U.L. APPROVED.
(E) C	SURFACE MOUNTED HALOGEN LIGHT FIXTURE INCLUDES CORROSION PROTECTED STEEL YOKE MOUNTING BRACKET TO A 4"X4" JUNCTION BOX, POWERED BY LOW VOLTAGE TRANSFORMER.	EXISTING	EXISTING HALOGEN	N/A	35 W	1	35 W MAX	120 V	ALTMAN: ALTMR6100CHQ WITH HALOGEN: GELMSMR16Q8TL	N/A	U.L. APPROVED.
(E) G	RAIL MOUNTED SPOT LIGHT WITH INTEGRAL POWER SUPPLY CORD FOR USE AS TRACK POWERED LIGHT FIXTURE.	EXISTING	EXISTING LED	N/A	16 W	1	35 W MAX	120 V	ALTMAN: ALTMR6100H2 WITH LED: GELM16Q8TL	N/A	U.L. APPROVED.
(E) K	WALL MOUNTED PORTABLE BORDER LIGHT FIXTURE WITH LOW VOLTAGE TRANSFORMER FOR LAMPS	EXISTING	EXISTING LED	N/A	30 W	5	150 W MAX	120 V	ALTMAN: ALTZS11H20HRGHT WITH LED: GEL30R20/18PK	N/A	U.L. APPROVED.
(E) H	RAIL MOUNTED SPOT LIGHT WITH INTEGRAL POWER SUPPLY CORD FOR USE AS TRACK POWERED LIGHT FIXTURE.	EXISTING	EXISTING LED	N/A	75 W	1	75 W MAX	120 V	ALTMAN: ALTPAR30H2 WITH LED: GEL75PAR30LHSP10	N/A	U.L. APPROVED.
(E) P	RAIL MOUNTED SPOT LIGHT WITH METAL EXTENDER MOUNTED TO A PIPE OR CEILING.	EXISTING	EXISTING LED	N/A	75 W	1	75 W MAX	120 V	ALTMAN: AAL7200MP-PANTOGRAP WITH LED: GEL75PAR30LHSP10	N/A	U.L. APPROVED.
(E) U	4' STRIP FLUORESCENT WITH CLEAR SLEEVE GUARD.	---	EXISTING FLUORESCENT	N/A	35 W	1	35 W MAX	120 V	DURAY: DUFEQH113Q-X WITH FLOURESCENT: GELF32T8SP25	N/A	U.L. APPROVED.

S OSM LIGHT FIXTURE SCHEDULE

E1.10 SCALE: NONE

ELECTRICAL DEVICE SCHEDULE

MARK	MANUFACTURER	MODEL	DESCRIPTION	WALLPLATE MANUFACTURER	WALLPLATE MODEL	WALLPLATE DESCRIPTION
GFCI	LEVITON	TDR20-W	DECORA PLUS DUPLEX RECEPTACLE OUTLET, HEAVY-DUTY INDUSTRIAL SPECIFICATION GRADE, TAMPER-RESISTANT, SMOOTH FACE, 20 AMP, 125 VOLT, BACK OR SIDE WIRE, NEMA 5-20R, 2-POLE, 3-WIRE, SELF-GRounding - WHITE	LEVITON	PJ26-W	1-GANG DECORA/GFCI DEVICE DECORA WALLPLATE, MIDWAY SIZE, THERMOPLASTIC NYLON, DEVICE MOUNT - WHITE
GFCI	LEVITON	7899-R	20 AMP, 125 VOLT RECEPTACLE, 20 AMP FEED-THROUGH, MONOCHROMATIC, SMARTLOCKPRO SERIES, BACK AND SIDE WIRED, NYLON WALLPLATE AND SCREWS INCLUDED - WHITE	LEVITON	PJ26-W	1-GANG DECORA/GFCI DEVICE DECORA WALLPLATE, MIDWAY SIZE, THERMOPLASTIC NYLON, DEVICE MOUNT - WHITE
IG	HUBBELL	IG5362W	STRAIGHT BLADE DEVICES, RECEPTACLES, DUPLEX, INDUSTRIAL GRADE, 2-POLE 3-WIRE GROUNDING, 20A 125V, 5-20R, BACK WIRED, ONE-PIECE BRASS INTEGRAL GROUND STRAP - WHITE	LEVITON	80703-W	1-GANG DUPLEX DEVICE RECEPTACLE WALLPLATE, STANDARD SIZE, THERMOPLASTIC NYLON, DEVICE MOUNT - WHITE
USB	LEVITON	T5833-W	COMBINATION DUPLEX RECEPTACLE/OUTLET, (1) TYPE "A" USB & (1) TYPE "C" USB CHARGING PORTS. 20 AMP, 125 VOLT, DECORA TAMPER-RESISTANT RECEPTACLE/OUTLET, NEMA 5-20R, GROUNDING, SIDE WIRED & BACK WIRED - WHITE	LEVITON	80301-SW	1-GANG DECORA/GFCI DEVICE DECORA WALLPLATE, MIDWAY SIZE, THERMOPLASTIC NYLON, DEVICE MOUNT - WHITE
	LEVITON	16352-2PW 16352-2PE	DECORA PLUS DUPLEX RECEPTACLE OUTLET, HEAVY-DUTY INDUSTRIAL SPECIFICATION GRADE, TWO OUTLETS MARKED "CONTROLLED", SMOOTH FACE, 20 AMP, 125 VOLT, BACK OR SIDE WIRE, NEMA 5-20R, 2-POLE, 3-WIRE, SELF-GROUNDING - WHITE ON CEILINGS, BLACK ON WALLS	LEVITON	PJ26-W PJ26-E	1-GANG DECORA/GFCI DEVICE DECORA WALLPLATE, MIDWAY SIZE, THERMOPLASTIC NYLON, DEVICE MOUNT - WHITE ON CEILINGS, BLACK ON WALLS
	LEVITON	TDR20-W	DECORA PLUS QUAD RECEPTACLE OUTLET, HEAVY-DUTY INDUSTRIAL SPECIFICATION GRADE, TAMPER-RESISTANT, SMOOTH FACE, 20 AMP, 125 VOLT, BACK OR SIDE WIRE, NEMA 5-20R, 2-POLE, 3-WIRE, SELF-GROUNDING - WHITE	LEVITON	PJ262-W	2-GANG DECORA/GFCI DEVICE DECORA WALLPLATE, MIDWAY SIZE, THERMOPLASTIC NYLON, DEVICE MOUNT - WHITE
USB	LEVITON	T5833-W	COMBINATION QUAD RECEPTACLE/OUTLET, (1) TYPE "A" USB & (1) TYPE "C" USB CHARGING PORTS. 20 AMP, 125 VOLT, DECORA TAMPER-RESISTANT RECEPTACLE/OUTLET, NEMA 5-20R, GROUNDING, SIDE WIRED & BACK WIRED - WHITE	LEVITON	PJ262-W	2-GANG DECORA/GFCI DEVICE DECORA WALLPLATE, MIDWAY SIZE, THERMOPLASTIC NYLON, DEVICE MOUNT - WHITE
$	HUBBELL	1221W	SWITCHES AND LIGHTING CONTROLS, HUBBELL-PRO SERIES, TOGGLE SWITCHES, GENERAL PURPOSE AC, SINGLE POLE, 20A 120/277V AC, BACK AND SIDE WIRED - WHITE	HUBBELL	NPIW	1-GANG WALLPLATE, STANDARD SIZE, TOGGLE, NYLON - WHITE
$3	HUBBELL	1223W	SWITCHES AND LIGHTING CONTROLS, HUBBELL- PRO SERIES, TOGGLE SWITCHES, GENERAL PURPOSE AC, THREE WAY, 20A 120/277V AC, BACK AND SIDE WIRED - WHITE	HUBBELL	NPIW	1-GANG WALLPLATE, STANDARD SIZE, TOGGLE, NYLON - WHITE
O	KILK	OS2/AP	PASSIVE INFRARED (PIR) OCCUPANCY SENSOR, CEILING MOUNTED - WHITE	LUTRON	CW-1-WH	1-GANG DECORA WALLPLATE, STANDARD SIZE - WHITE
O	LUTRON	MS-A202-WH	MAESTRO DUAL-CIRCUIT DUAL-TECH OCCUPANCY/MOTION SENSOR SWITCH, NO NEUTRAL, SINGLE-POLE, WALL MOUNTED - WHITE	LUTRON	CW-1-WH	1-GANG DECORA WALLPLATE, STANDARD SIZE - WHITE
O FR	HUBBELL	WSI000NW	PASSIVE INFRARED (PIR) OCCUPANCY SENSOR, CEILING MOUNTED - WHITE	HUBBELL	RCNIW	1-GANG SNAP-ON WALLPLATE - WHITE
	COOPER	B-LINE	CABLE TRAY - 6" NEMA LOADING DEPTH, PRE-GALVANIZED STEEL, TROUGH NON-VENTILATED BOTTOM, 6" WIDTH, 10' OR 12' LENGTHS	-	-	-
	-	-	INDUSTRIAL STRENGTH IP67 RATED LED LIGHT WITH METAL GUARD	-	-	-
B	EDWARDS	694-B	LOW VOLTAGE, PROTRUDING CENTER PUSH BUTTON, SNAP FIT MOUNT - BLACK	-	-	-
K	EDWARDS	692-W	LOW VOLTAGE, RECESSED CENTER PUSH BUTTON, SNAP FIT MOUNT - WHITE	-	-	-
	EDWARDS	730	LOW VOLTAGE, NON ADJUSTABLE COMBINATION BELL AND BUZZER WITH GROUNDED FRAME - SATIN ALUMINUM	-	-	-
T	EDWARDS	598	LOW VOLTAGE TRANSFORMER, HIGH POWER FOR LONG WIRE RUNS OR FOR APPLICATIONS REQUIRING GREATER POWER	EDWARDS	593	TRANSFORMER MOUNTING PLATE, ALLOWS FOR MOUNTING COMPLETELY ENCLOSED IN TWO GANG ELECTRICAL BOX
$M	WATTSTOPPER	WS-301	PIR WALL SWITCH OCCUPANCY SENSOR 120/277V WHITE	LEVITON	PJ26-W	1-GANG DECORA/GFCI DEVICE DECORA WALLPLATE, MIDWAY SIZE, THERMOPLASTIC NYLON, DEVICE MOUNT - WHITE
$M	LEVITON	5657-2W	15 AMP, 120/277 VOLT, DECORA PLUS ROCKER DOUBLE-THROW CTR-OFF MOMENTARY CONTACT SINGLE-POLE AC QUIET SWITCH, COMMERCIAL SPEC GRADE, SELF GROUNDING, BACK & SIDE WIRED - WHITE (PROVIDED BY EMS VENDOR)	LEVITON	PJ26-W	1-GANG DECORA/GFCI DEVICE DECORA WALLPLATE, MIDWAY SIZE, THERMOPLASTIC NYLON, DEVICE MOUNT - WHITE
O EMS	KELE	LX-24	PASSIVE INFRARED (PIR) OCCUPANCY SENSOR SPECIFICALLY DESIGNED TO INTERFACE WITH BUILDING AUTOMATION SYSTEMS, PENDENT MOUNTED - WHITE (PROVIDED BY EMS VENDOR)	-	-	-
TC	-	-	GC PROVIDED TIMECLOCK, REFER TO 'LIGHTING CONTROL DETAIL (GC SUPPLIED AND INSTALLED)' ON SHEET E1.01 FOR SPECIFICATION.	-	-	-
P	-	-	GC PROVIDED POWER PACK, REFER TO 'NON-SALES ON/OFF POWER PACK DETAIL' ON SHEET E1.01 FOR SPECIFICATION.	-	-	-
HD	DYSON	AIRBLADE V	HAND DRYER ENGINEERED FOR HYGENIC PERFORMANCE, 120V, 1000W, 79DB, HEPA FILTER - SPRAYED NICKEL	-	-	-

E GC PROVIDED ELECTRICAL DEVICE SCHEDULE

E1.10 SCALE: NONE

HOLLISTER CALIFORNIA

ABERCROMBIE & FITCH CO.
6301 FITCH PATH
NEW ALBANY, OHIO 43054
614-283-6500

SHREMSHOCK

Shremshock Engineering, Inc.
7775 Walton Parkway Ste. 250 New Albany, OH 43054
t: 614.545.4555 | f: 614.545.4555

info@shremshock.com
www.shremshock.com

THE ARCHITECT / ENGINEER ASSUMES NO RESPONSIBILITY OR LIABILITY FOR THE USE OF THESE PLANS FOR ANY PROJECT OTHER THAN SPECIFICALLY AUTHORIZED BY THEM AND SIGNED AND SEALED FOR SUCH SPECIFIC LOCATION IN THE STATE OF OHIO BEARING THEIR ORIGINAL SEAL. THIS BUILDING USE IS ONLY APPLICABLE IN AREAS MEETING THE STATED DESIGN CRITERIA.

THE AVENUE OF MURFREESBORO


2615 MEDICAL CENTER PARKWAY
MURFREESBORO, TN 37129
STORE #3684

Project No.:	260356
Drawn By:	NRE
Date	Issue
10-12-2026	BID SET

ELECTRICAL / LIGHTING SCHEDULES

E1.10

Plot date: OCT 13 2025

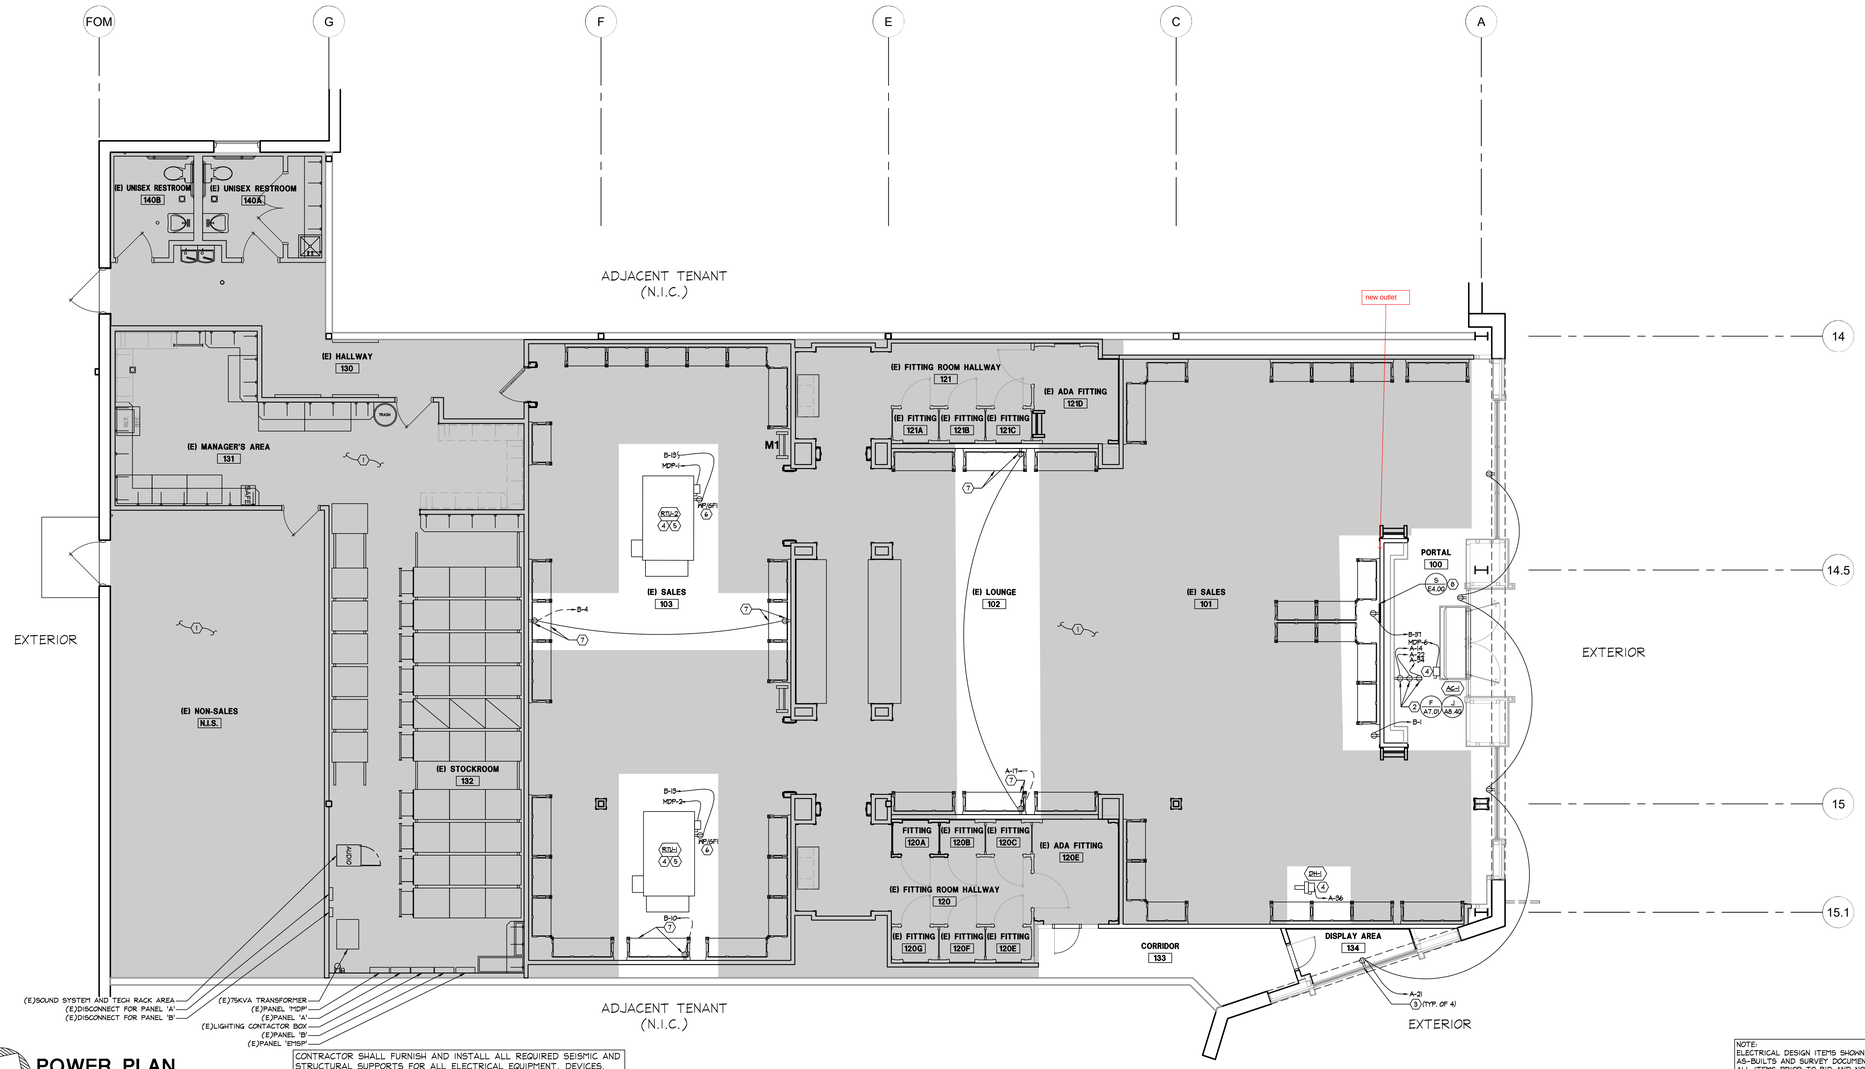

POWER PLAN
SCALE: 3/16"=1'-0"

CONTRACTOR SHALL FURNISH AND INSTALL ALL REQUIRED SEISMIC AND STRUCTURAL SUPPORTS FOR ALL ELECTRICAL EQUIPMENT, DEVICES, CONDUIT, LIGHTING, ETC. PROVIDE LATERAL SUPPORT AS REQUIRED PER THE LOCALLY ADOPTED BUILDING CODE SEISMIC DESIGN CATEGORY D. FIELD VERIFY AND COORDINATE ALL REQUIREMENTS WITH AUTHORITY HAVING JURISDICTION.

NOTE:
ELECTRICAL DESIGN ITEMS SHOWN ON THIS PLAN ARE BASED ON PROVIDED AS-BUILTS AND SURVEY DOCUMENTATION. CONTRACTOR SHALL FIELD VERIFY ALL ITEMS PRIOR TO BID AND NOTIFY HOLLISTER CONSTRUCTION MANAGER OF ANY ITEMS THAT MAY IMPACT CONSTRUCTION.

POWER PLAN GENERAL NOTES

A. REFER TO SHEET E0.01 FOR ELECTRICAL SPECIFICATIONS.
B. REFER TO SHEET E0.10 FOR ELECTRICAL SYMBOLS AND ABBREVIATIONS.
C. REFER TO SHEET E1.00 FOR ADDITIONAL INFORMATION ON ELECTRICAL PANELS AND SCHEMATICS.
D. REFER TO SHEET E1.10 FOR ADDITIONAL INFORMATION ON ELECTRICAL DEVICES AND FIXTURES.
E. ~~REFER TO SHEET E5.00 FOR ELECTRICAL DETAILS.~~
F. ALL NON-SALES OUTLETS SHALL BE LABELED ON THE WALLPLATE WITH THE CIRCUIT NUMBER (PRINTED, NOT HAND WRITTEN).
G. ALL ELECTRICAL PANELS SHALL BE LABELED ON THE FRONT OF THE PANEL PER N.E.C.

(#) POWER PLAN CODED NOTES

1. ALL EXISTING RECEPTACLES, HVAC EQUIPMENT, OR OTHER ELECTRICAL DEVICES AND ASSOCIATED CIRCUITING IN SHADED AREAS ARE TO REMAIN AS-IS UNLESS OTHERWISE NOTED ON THE ARCHITECTURAL DEMOLITION PLAN. CONNECTED LOADS ARE ACCOUNTED FOR IN PANEL SCHEDULES ON SHEET E1.00.
2. COORDINATE MOUNTING HEIGHT FOR THE ENTRY VIDEO WALL RECEPTACLE WITH ARCHITECTURAL DETAILS INDICATED ON PLAN PRIOR TO INSTALLATION. REUSE EXISTING CIRCUITS IN THE AREA FROM PREVIOUSLY REMOVED VIDEO WALL FOR CONNECTION TO NEW RECEPTACLES IN NEW LOCATIONS, REROUTING/EXTENDING EXISTING CIRCUITS AS NECESSARY. FIELD VERIFY ALL EXISTING CONDITIONS.
3. RECEPTACLE TO BE MOUNTED ON CEILING OR ON WALL WITHIN 18" OF THE TOP OF THE SHOW WINDOW PER N.E.C. AND BE ALL BLACK IN COLOR. HOMERUN CIRCUIT THROUGH CONTACTOR CONTROLLED BY TIMECLOCK. REFER TO LIGHTING CONTROL DETAIL ON SHEET E1.01 FOR MORE INFORMATION. REFER TO ARCHITECTURAL DRAWINGS FOR FURTHER INFORMATION REGARDING LOCATIONS.
4. PROVIDE MEANS OF DISCONNECT PER THE ELECTRICAL CONNECTION SCHEDULE ON SHEET E1.00.
5. REUSE/RECONNECT EXISTING LOW VOLTAGE CABLE FOR HVAC CONTROLS. REFER TO SHEET E.400 FOR MORE INFORMATION.
6. PROVIDE GFI DUPLEX RECEPTACLE ADJACENT TO UNIT IF NOT FURNISHED WITH EQUIPMENT. PROVIDE CIRCUIT AS INDICATED, FURNISH WEATHER PROOF ENCLOSURES AND COVERS AS REQUIRED.
7. RELOCATED CABINET WITH RECEPTACLE. VERIFY EXISTING HEIGHT AND ALL REQUIREMENTS PRIOR TO RELOCATION.
8. EXISTING SENSORMATIC COMPONENTS ABOVE CEILING TO BE REPLACED WITH NEW EAS SYSTEM IN APPROXIMATELY THE SAME ACCESSIBLE AREA. PROVIDE NEW 3/4" FIRE RATED PLYWOOD BACKBOARD FOR EAS COMPONENTS AND RECEPTACLE.

HOLLISTER
CALIFORNIA

ABERCROMBIE & FITCH CO.
6301 FITCH PATH
NEW ALBANY, OHIO 43054
614-283-6500

SHREMSHOCK
Shremshock Engineering, Inc.
7775 Walton Parkway Ste. 250 New Albany, OH 43054
t: 614 545 4500 | f: 614 545 4555
info@shremshock.com
www.shremshock.com

THE ARCHITECT / ENGINEER ASSUMES NO RESPONSIBILITY OR LIABILITY FOR THE USE OF THESE PLANS FOR ANY PROJECT OTHER THAN SPECIFICALLY AUTHORIZED BY THEM AND SIGNED AND SEALED FOR SUCH SPECIFIC LOCATION IN THE SPACE PROVIDED ADJACENT TO THEIR ORIGINAL SEAL. THIS BUILDING USE IS ONLY APPLICABLE IN AREAS MEETING THE STATED DESIGN CRITERIA.


THE AVENUE OF MURFREESBORO
2615 MEDICAL CENTER PARKWAY
MURFREESBORO, TN 37129
STORE #3684

Project No.:	260356
Drawn By:	NRE
Date	Issue
10-12-2026	BID SET

POWER PLAN

E2.00

Plot date: OCT 13 2025

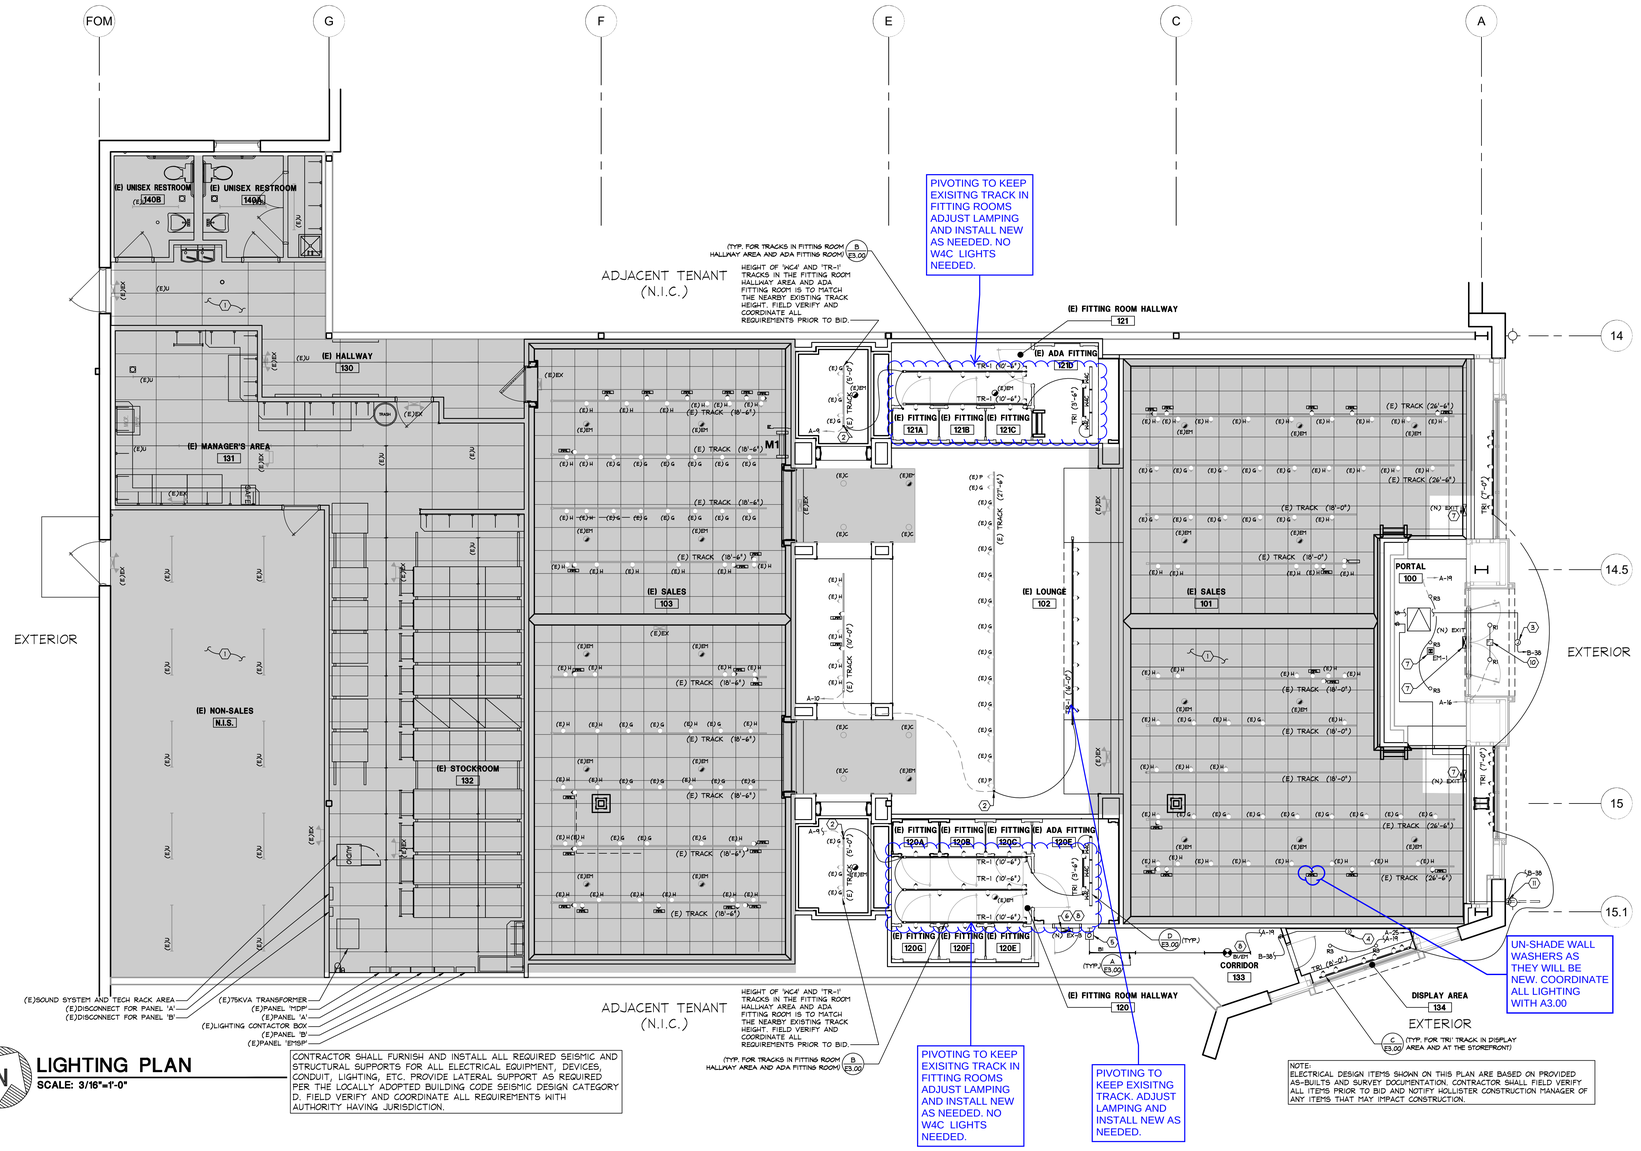

LIGHTING PLAN
SCALE: 3/16"=1'-0"

CONTRACTOR SHALL FURNISH AND INSTALL ALL REQUIRED SEISMIC AND STRUCTURAL SUPPORTS FOR ALL ELECTRICAL EQUIPMENT, DEVICES, CONDUIT, LIGHTING, ETC. PROVIDE LATERAL SUPPORT AS REQUIRED PER THE LOCALLY ADOPTED BUILDING CODE SEISMIC DESIGN CATEGORY D. FIELD VERIFY AND COORDINATE ALL REQUIREMENTS WITH AUTHORITY HAVING JURISDICTION.

GENERAL NOTES

A. REFER TO SHEET E0.01 FOR ELECTRICAL SPECIFICATIONS.
B. REFER TO SHEET E0.10 FOR ELECTRICAL SYMBOLS AND ABBREVIATIONS.
C. REFER TO SHEET E1.00 FOR ADDITIONAL INFORMATION ON ELECTRICAL PANELS AND SCHEMATICS.
D. REFER TO SHEET E1.10 FOR ADDITIONAL INFORMATION ON ELECTRICAL DEVICES AND FIXTURES.
E. ~~REFER TO SHEETS E6.00 AND E6.01 FOR ELECTRICAL DETAILS AND ELEVATIONS (IF NOT NOTED ON PLAN).~~
F. WIRE ALL EXIT SIGNS AHEAD OF ALL LOCAL SWITCHING, CONTROLS, AND CONTACTORS.
G. MOUNT LIGHTING TRACK END SO THAT FEEDS ARE TOWARDS BACK OF STORE.

EXISTING SEVEN-DAY, 24-HOUR TIME CLOCK CONTROLLING LIGHTING SHALL REMAIN AND BE MODIFIED AS REQUIRED. CONTRACTOR SHALL VERIFY OPERATION AND ADJUST TIME CLOCK SETTINGS TO ENSURE ILLUMINATION OF STOREFRONT AND SIGN WINDOWS FROM DUSK UNTIL 12:00 A.M. (MIDNIGHT) PER LANDLORD CRITERIA. REFER TO THIS SHEET AND E1.01 FOR ANY ADDITIONAL REQUIREMENTS.

LIGHTING PLAN CODED NOTES


1. EXISTING LIGHTING, CIRCUITING, AND ASSOCIATED CONTROLS IN SHADED AREAS ARE TO REMAIN UNLESS OTHERWISE NOTED ON PLAN. CONNECTED LOADS ARE ACCOUNTED FOR IN PANEL SCHEDULES ON SHEET E1.00. CONTRACTOR TO RELAMP ALL EXISTING LIGHTING WITHIN TENANT SPACE.
2. EXTEND CONDUIT/WIRING FROM NEARBY TRACK SEGMENT AND/OR LIGHT AND CONNECT AS INDICATED ON PLAN. FIELD VERIFY EXISTING CONDITIONS, CIRCUIT, DESIGNATION, AND ALL REQUIREMENTS PRIOR TO BID AND THE START OF WORK.
3. JUNCTION BOX WITH DISCONNECTING MEANS FOR STOREFRONT SIGN. INSTALL ABOVE LAY-IN CEILING IN AN ACCESSIBLE LOCATION. COORDINATE EXACT LOCATION IN FIELD WITH SIGN VENDOR FOR BEST LOCATION OF JUNCTION BOX AND ROUTING OF POWER FROM JUNCTION BOX TO SIGNAGE. IF NEW SIGNAGE DOES NOT COME WITH A PHOTOCELL, THIS CONTRACTOR SHALL PROVIDE A 120/277V ON/OFF EXTERIOR PHOTOCELL (INTERMATIC NIGHTFOX SERIES OR EQUAL), MOUNT FACING NORTH ON ROOF ADJACENT TO RTU. COORDINATE EXACT LOCATION IN FIELD WITH OWNER REPRESENTATIVE. REFER TO ARCHITECTURAL ELEVATIONS FOR SIGNAGE LOCATION.
4. JUNCTION BOX WITH DISCONNECTING MEANS FOR DISPLAY WINDOW SIGN ON INTERIOR WALL. INSTALL DISCONNECT IN AN ACCESSIBLE LOCATION IN THE CORRIDOR. JUNCTION BOX IS TO BE CENTERED ON SIGN ON WALL. COORDINATE EXACT LOCATION IN FIELD WITH SIGN VENDOR FOR BEST LOCATION OF JUNCTION BOX AND ROUTING OF POWER FROM JUNCTION BOX TO SIGNAGE. REFER TO ARCHITECTURAL ELEVATIONS FOR SIGNAGE LOCATION.
5. OCCUPANCY SENSOR SWITCH (SET TO VACANCY OPERATION) TO BE LOCAL CONTROL FOR TRACK FIXTURES ~~AND ANY FIXTURES IN FITTING ROOMS~~. OCCUPANCY SENSOR TO BE MOUNTED AT 45" A.F.F. TO CENTER OF BOX AND HAVE AUTOMATIC OFF AFTER 30 SECONDS.
6. EXIT SIGN TO BE MOUNTED DIRECTLY ABOVE DOOR FRAME.
7. SALES AREA EXIT SIGN, OR EMERGENCY LIGHT, IS TO BE WIRED TO UNSWITCHED CIRCUIT A-23.
8. CIRCUIT NON-SALES EXIT AND EMERGENCY TO LOCAL LIGHTING CIRCUIT AHEAD OF ALL SWITCHING. EMERGENCY LIGHTING DESIGNATED 'EM' IS TO HAVE EMERGENCY DRIVER/BATTERY BACKUP CIRCUITED TO LOCAL LIGHTING CIRCUIT AHEAD OF ALL SWITCHING AND NORMAL BALLAST CIRCUITED AS INDICATED TO ALLOW LIGHTS TO SWITCH WITH THE REST OF THE CIRCUIT DURING NORMAL, NON-EMERGENCY OPERATION.

   PROVIDE WALL MOUNTED OCCUPANCY SENSOR SWITCH FOR CONTROL OF LIGHTING AS SHOWN. SET SWITCH TO 'AUTOMATIC-ON' OPERATION AND TO TURN OFF LIGHTING AUTOMATICALLY WITHIN 15 MINUTES OF ROOM VACANCY.
10. EXTERIOR STOREFRONT LIGHTING TO UTILIZE EXISTING LIGHTING CONTROL. TO COMPLY WITH EXTERIOR LIGHTING REQUIREMENTS THIS CONTRACTOR SHALL PROVIDE A PHOTOCELL THAT INTERCEPTS THE CIRCUIT TO CONTROL THE EXTERIOR STOREFRONT LIGHTS SO THAT THE LIGHTS AUTOMATICALLY TURN OFF WHEN DAYLIGHT IS PRESENT AND SATISFIES THE LIGHTING NEEDS. THE PHOTOCELL SHALL BE MOUNTED IN AN UNOBTRUSIVE LOCATION.
11. JUNCTION BOX WITH DISCONNECTING MEANS FOR BLADE SIGN. INSTALL ABOVE LAY-IN CEILING IN AN ACCESSIBLE LOCATION. COORDINATE EXACT LOCATION IN FIELD WITH SIGN VENDOR FOR BEST LOCATION OF JUNCTION BOX AND ROUTING OF POWER FROM JUNCTION BOX TO SIGNAGE. IF NEW SIGNAGE DOES NOT COME WITH A PHOTOCELL, THIS CONTRACTOR SHALL PROVIDE A 120/277V ON/OFF EXTERIOR PHOTOCELL (INTERMATIC NIGHTFOX SERIES OR EQUAL), MOUNT FACING NORTH ON ROOF ADJACENT TO RTU. COORDINATE EXACT LOCATION IN FIELD WITH OWNER REPRESENTATIVE. REFER TO ARCHITECTURAL ELEVATIONS FOR SIGNAGE LOCATION.


REMOVE NOTE

NOT SHOWN IN ABOVE PLANS. SWAP WITH CODED NOTE 5 IN PLAN VIEW


NOTE:
ELECTRICAL DESIGN ITEMS SHOWN ON THIS PLAN ARE BASED ON PROVIDED AS-BUILTS AND SURVEY DOCUMENTATION. CONTRACTOR SHALL FIELD VERIFY ALL ITEMS PRIOR TO BID AND NOTIFY HOLLISTER CONSTRUCTION MANAGER OF ANY ITEMS THAT MAY IMPACT CONSTRUCTION.

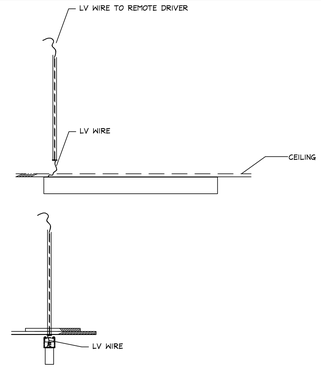


D W4C FIXTURE MOUNT
E3.00 SCALE: NONE

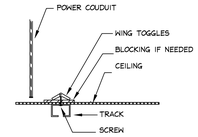

C TRACK - SURFACE MOUNTED
E3.00 SCALE: NONE

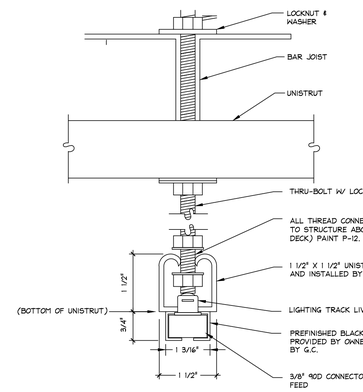

B TRACK - SUSPENDED
E3.00 SCALE: NONE

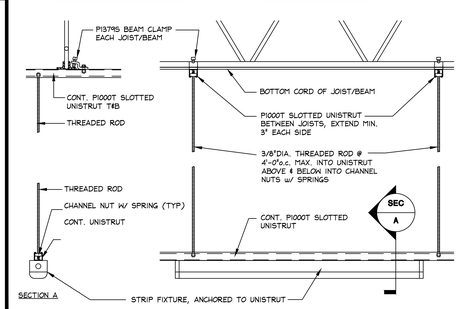

NOTES:
1. UNISTRUT, THREADED ROD AND CONNECTIONS SUPPLIED AND INSTALLED BY CONTRACTOR.

A UNIVERSAL FIXTURE MOUNT
E3.00 SCALE: NONE

HOLLISTER CALIFORNIA

ABERCROMBIE & FITCH CO.
6301 FITCH PATH
NEW ALBANY, OHIO 43054
614-283-6500

SHREMSHOCK
Shremshock Engineering, Inc.
7775 Walton Parkway Ste. 250 New Albany, OH 43054
t: 614.545.4500 | f: 614.545.4555
info@shremshock.com
www.shremshock.com

THE ARCHITECT / ENGINEER ASSUMES NO RESPONSIBILITY OR LIABILITY FOR THE USE OF THESE PLANS FOR ANY PROJECT OTHER THAN SPECIFICALLY AUTHORIZED BY THEM AND SIGNED AND SEALED FOR SUCH SPECIFIC LOCATION IN THE STATE OF THE PROJECT. WITHOUT THEIR SIGNED AND SEALED, THIS BUILDING USE IS ONLY APPLICABLE IN AREAS MEETING THE STATED DESIGN CRITERIA.

THE AVENUE OF MURFREESBORO
2615 MEDICAL CENTER PARKWAY
MURFREESBORO, TN 37129
STORE #3684


Project No.:	260356
Drawn By:	NRE
Date	Issue
10-12-2026	BID SET

LIGHTING PLAN

E3.00

Plot date: OCT 13 2025


NOTE:
ELECTRICAL DESIGN ITEMS SHOWN ON THIS PLAN ARE BASED ON PROVIDED AS-BUILTS AND SURVEY DOCUMENTATION. CONTRACTOR SHALL FIELD VERIFY ALL ITEMS PRIOR TO BID AND NOTIFY HOLLISTER CONSTRUCTION MANAGER OF ANY ITEMS THAT MAY IMPACT CONSTRUCTION.

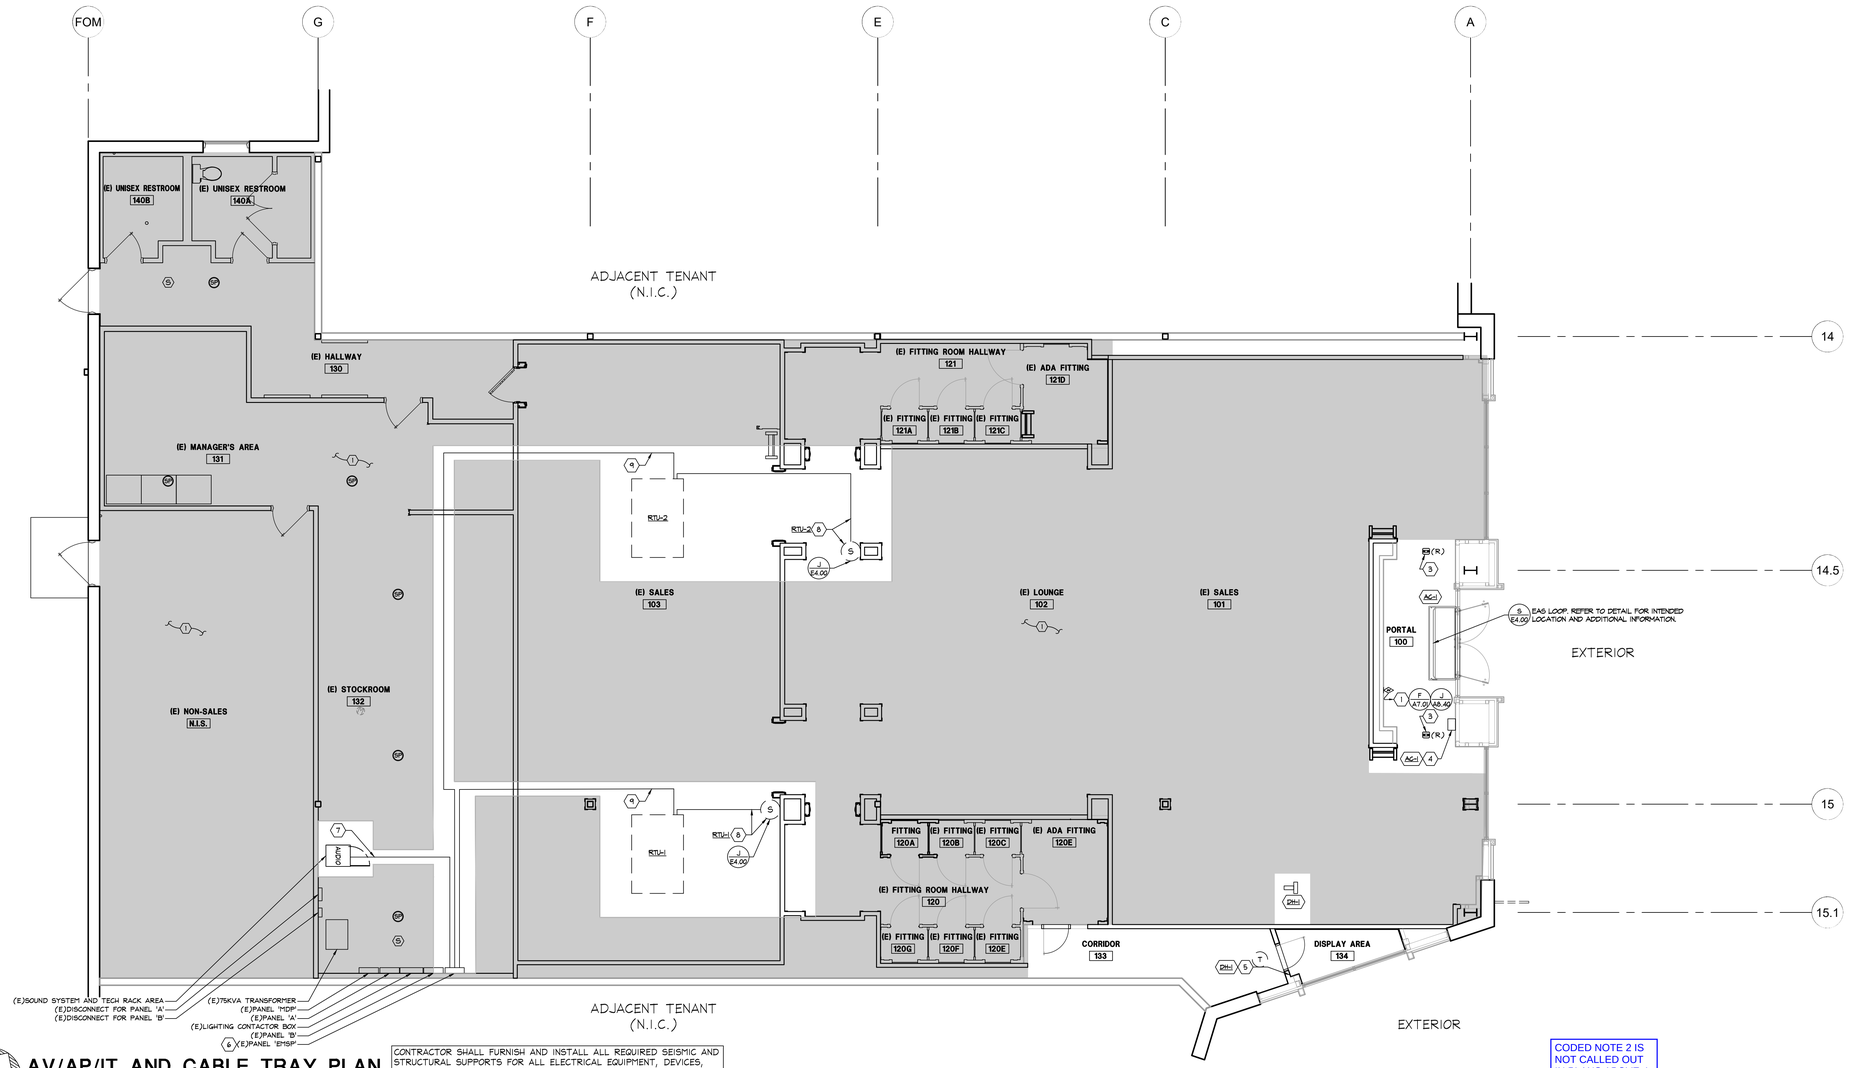


AV/AP/IT AND CABLE TRAY PLAN
SCALE: 3/16"=1'-0"

CONTRACTOR SHALL FURNISH AND INSTALL ALL REQUIRED SEISMIC AND STRUCTURAL SUPPORTS FOR ALL ELECTRICAL EQUIPMENT, DEVICES, CONDUIT, LIGHTING, ETC. PROVIDE LATERAL SUPPORT AS REQUIRED PER THE LOCALLY ADOPTED BUILDING CODE SEISMIC DESIGN CATEGORY D. FIELD VERIFY AND COORDINATE ALL REQUIREMENTS WITH AUTHORITY HAVING JURISDICTION.

CODED NOTE 2 IS NOT CALLED OUT IN PLANS ABOVE. I BELIEVE THERE WAS A MISTAKE IN THE PLAN VIEW AND ITS SHOWN A "1".

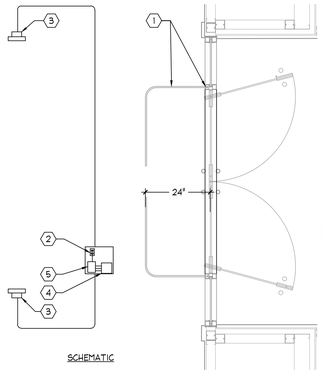


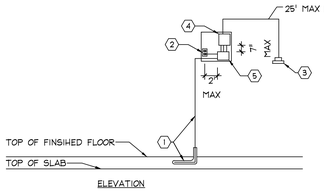

(#) EAS - 3004 LOOP CODED NOTES

1. 1/2" PVC IN FLOOR AND STUBBED UP INSIDE WALL OR EXTENDED AROUND STOREFRONT OPENING IF REQUIRED BY MALL OR LOCAL CODE (OWNER VENDOR TO INSTALL CABLE) WITH PULLSTRING
2. RECEPTACLE MOUNTED ON PLYWOOD
3. OWNER VENDOR TO INSTALL REMOTE ALARMS
4. OWNER VENDOR TO INSTALL POWER PACK
5. OWNER VENDOR TO INSTALL CAP BOARD (AS CLOSE AS POSSIBLE TO POWER PACK)

S E4.00 **EAS - 3004 LOOP**
SCALE: NONE

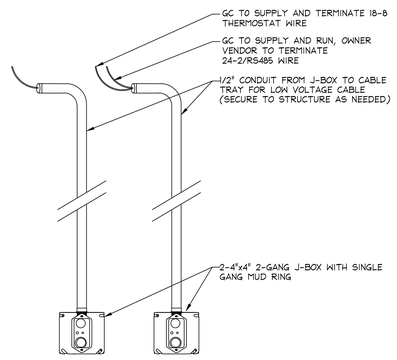

J E4.00 **TEMPERATURE SENSOR BACKBOX & CONDUIT**
SCALE: NONE

AV/AP/IT AND CABLE TRAY PLAN GENERAL NOTES

A. REFER TO SHEET E0.01 FOR ELECTRICAL SPECIFICATIONS.
B. REFER TO SHEET E0.10 FOR ELECTRICAL SYMBOLS AND ABBREVIATIONS.
C. REFER TO SHEET E1.10 FOR ADDITIONAL INFORMATION ON ELECTRICAL DEVICES & FIXTURES.
D. ~~REFER TO SHEET E6.00 AND E6.01 FOR ELECTRICAL DETAILS AND ELEVATIONS (IF NOT NOTED ON PLAN).~~
E. LOW VOLTAGE CABLE LEGEND:
   - N = IT NETWORK RUNS
     - 100X = PEOPLE COUNTERS
     - 101X = CASHWRAP
     - 102X = BACKWRAP
     - 103X = HAP
     - 104X = MANAGERS DESK A
     - 105X = OUTSIDE DATA CONNECTION
     - 106X = ENERGY METER
     - 107X = EMS PANEL
     - 108X = PHONE
     - 109X = MISCELLANEOUS
   - D = AV DATA RUN
     - 10X = FIELD
     - 25X = IP UNITS
   - T = AP WIRING
     - 100X = EAS
     - 101X = KVM EXTENDER
   - S = SPEAKER
   - C = CAMERA
   - H = HVAC
   - V = VIDEO DATA TO LED CONTROLLER
F. ALL CABLES AT TECH RACK LOCATION TO BE BROUGHT TO THE FLOOR AND LEFT WITH 15-FEET OF SERVICE LOOP
G. ALL CABLES AT LOW VOLTAGE FIELD DEVICES TO BE LEFT WITH A SERVICE LOOP THAT REACHES 6'-0" AFF, OR 4'-0" OF SERVICE LOOP AT WALL BOXES/DEVICES
H. ALL CABLES AT THE CASHWRAP TO HAVE 5'-0" SERVICE LOOP OUT OF THE FINAL TERMINATION BOX.
I. ALL CABLING TO BE SECURELY LABELED WITH LABEL MAKER WITH FULL CABLE NAME/NUMBER AT BOTH ENDS WHERE IT LEAVES THE WALL/BOX AND AT THE END OF THE CABLE. TOTAL 4 LABELS PER WIRE.
J. ALL EXPOSED LOW VOLTAGE CABLING MUST BE CONTAINED IN CONDUIT.
K. REFER TO E1.00 SERIES SHEETS FOR ADDITIONAL INFORMATION ON ELECTRICAL PANELS & SCHEMATICS.

(#) AV/AP/IT AND CABLE TRAY PLAN CODED NOTES

1. CONNECT NEW A/V OUTLET TO EXISTING DATA CABLING FROM PREVIOUSLY REMOVED VIDEO WALL IN THE AREA. FIELD VERIFY ALL EXISTING CONDITIONS AND CABLE TYPE. REPLACE WITH CAT-6 - BLACK - COMMSCOPE - 2071E - 700210230 | 2071E BLK C6 4/23 U/UTP W1000 - NO SUBSTITUTIONS - IF EXISTING CABLING IS NOT SUFFICIENT FOR NEW VIDEO DISPLAY.
2. EXISTING AV/AP/UT EQUIPMENT IN SHADED AREAS ARE TO REMAIN AS-IS UNLESS OTHERWISE NOTED ON PLAN.
3. EXISTING PEOPLE COUNTERS TO BE RELOCATED IN APPROXIMATELY THE SAME LOCATION AS EXISTING. SURFACE MOUNT ON NEW CEILING AND EXTEND WIRING, MATCHING EXISTING, AS REQUIRED TO ENSURE A COMPLETE AND FULLY FUNCTIONAL SYSTEM. FIELD VERIFY AND COORDINATE ALL REQUIREMENTS PRIOR TO BID.
4. AIR CURTAIN THERMOSTAT TO OPERATE INDEPENDENTLY OF OWNER PROVIDED HVAC PANEL. THERMOSTAT TO HAVE LOCKING COVER FOR MAINTENANCE TO CONTROL SETPOINT OF THERMOSTAT.
5. DUCT HEATER THERMOSTAT TO OPERATE INDEPENDENTLY OF OWNER PROVIDED HVAC PANEL.
6. EXISTING HVAC CONTROL DEVICE TO BE RECONFIGURED BY HOLLISTER'S VENDOR TO ACCOMMODATE NEW WORK. CONTRACTOR SHALL WORK WITH HOLLISTER VENDOR TO ENSURE PROPER OPERATION. REPAIR/REPLACE ANY DEFECTIVE PARTS. FIELD VERIFY EXACT LOCATION AND ALL REQUIREMENTS WITH HOLLISTER CONSTRUCTION MANAGER PRIOR TO BID.
7. (1) CAT-6 - BLACK - COMMSCOPE - 2071E - 700210230 | 2071E BLK C6 4/23 U/UTP W1000 - NO SUBSTITUTIONS UNLESS OTHERWISE DIRECTED WITH WRITTEN APPROVAL - TO TECHNOLOGY RACK. ROUTING SHOWN FOR REFERENCE. CONTRACTOR TO FIELD VERIFY ROUTING PATH AND REUSE EXISTING ROUTING PATH WHEN POSSIBLE. LEAVE WIRE FOR HOLLISTER'S VENDOR TO TERMINATE AND COMMISSION. FIELD VERIFY EXACT LOCATION AND ALL REQUIREMENTS WITH HOLLISTER CONSTRUCTION MANAGER PRIOR TO BID.
8. (1) 18-8 - BLACK BELDEN 5306FE - FROM HVAC TO TEMPERATURE SENSOR. CONTRACTOR TO FIELD VERIFY ROUTING PATH AND REUSE EXISTING ROUTING PATH WHEN POSSIBLE. LEAVE WIRE FOR HOLLISTER'S VENDOR TO TERMINATE AND COMMISSION. FIELD VERIFY EXACT LOCATION AND ALL REQUIREMENTS WITH HOLLISTER CONSTRUCTION MANAGER PRIOR TO BID.
9. (1) 24-2 - BLACK BLENDON 9841LW - RS485 CABLE - DAISY CHAINED WIRE PULL FROM RECONFIGURED EMSP PANEL TO TECH RACK. CONTRACTOR TO FIELD VERIFY ROUTING PATH AND REUSE EXISTING ROUTING PATH WHEN POSSIBLE. LEAVE WIRE FOR HOLLISTER'S VENDOR TO TERMINATE AND COMMISSION. FIELD VERIFY EXACT LOCATION AND ALL REQUIREMENTS WITH HOLLISTER CONSTRUCTION MANAGER PRIOR TO BID.

HOLLISTER CALIFORNIA
ABERCROMBIE & FITCH CO.
6301 FITCH PATH
NEW ALBANY, OHIO 43054
614-283-6500

SHREMSHOCK
Shremshock Engineering, Inc.
7775 Walton Parkway Ste. 250 New Albany, OH 43054
t: 614 545 4500 | f: 614 545 4555
info@shremshock.com
www.shremshock.com

THE ARCHITECT / ENGINEER ASSUMES NO RESPONSIBILITY OR LIABILITY FOR THE USE OF THESE PLANS FOR ANY PROJECT OTHER THAN SPECIFICALLY AUTHORIZED BY THEM AND SIGNED AND SEALED FOR SUCH SPECIFIC LOCATION IN THE SPACE PROVIDED ADJACENT TO THEIR ORIGINAL SEAL. THIS BUILDING USE IS ONLY APPLICABLE IN AREAS MEETING THE STATED DESIGN CRITERIA.


THE AVENUE OF MURFREESBORO
2615 MEDICAL CENTER PARKWAY
MURFREESBORO, TN 37129
STORE #3684

Project No.:	260356
Drawn By:	NRE
Date	Issue
10-12-2026	BID SET

AV/AP/IT AND CABLE TRAY PLAN

E4.00

Plot date: OCT 13 2025

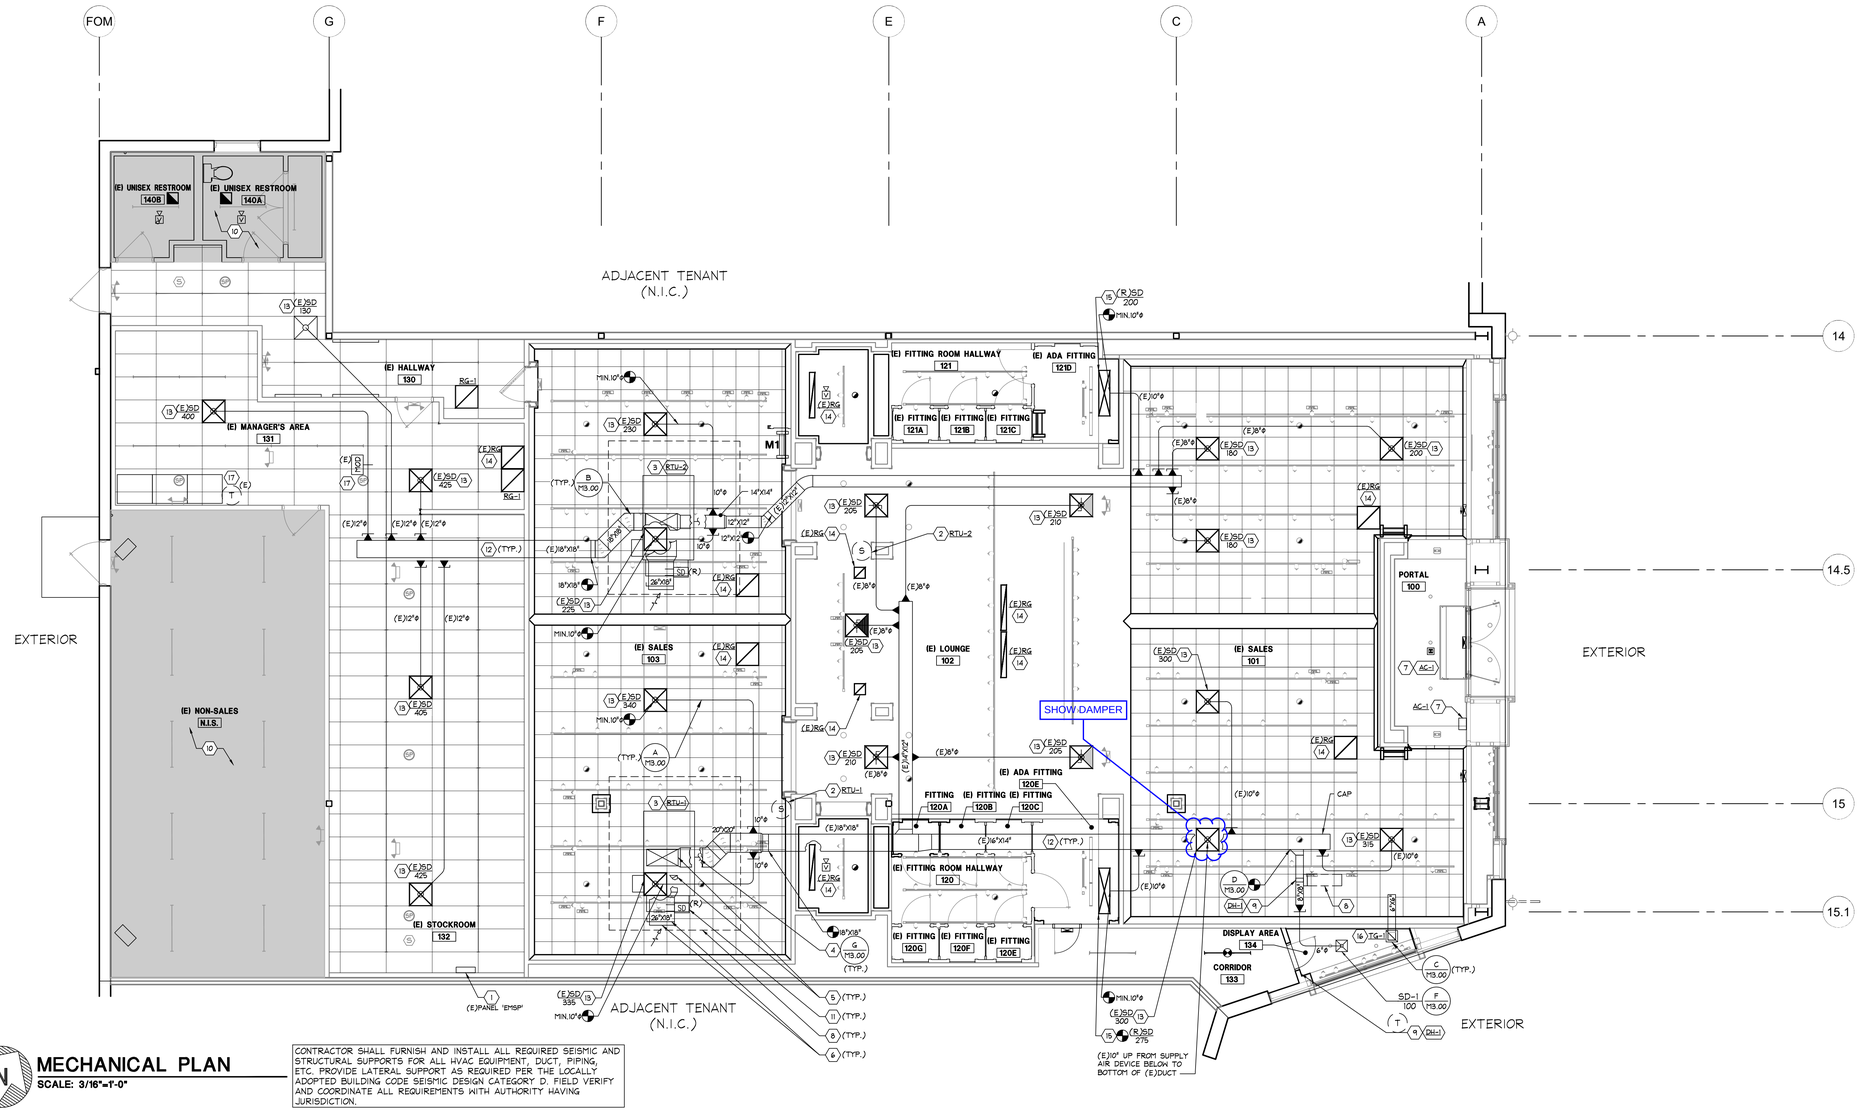

MECHANICAL PLAN
SCALE: 3/16"=1'-0"

CONTRACTOR SHALL FURNISH AND INSTALL ALL REQUIRED SEISMIC AND STRUCTURAL SUPPORTS FOR ALL HVAC EQUIPMENT, DUCT, PIPING, ETC. PROVIDE LATERAL SUPPORT AS REQUIRED PER THE LOCALLY ADOPTED BUILDING CODE SEISMIC DESIGN CATEGORY D. FIELD VERIFY AND COORDINATE ALL REQUIREMENTS WITH AUTHORITY HAVING JURISDICTION.

GENERAL NOTES

A. COORDINATE ROUTE OF DUCTWORK WITH SUPPORTS FOR LIGHTING IN ALL SALES AREA. REFER TO ELECTRICAL LIGHTING PLAN FOR FURTHER INFORMATION.

B. TEMPERATURE SENSORS TO BE MOUNTED 45" AFF UNLESS OTHERWISE NOTED.

C. ~~ALL NON-SALES AREA GRILLES SHALL BE MOUNTED AT 12'-0".~~

D. ALL MECHANICAL EQUIPMENT SHALL BE LABELED HOL-XXX-# (WHERE XXX IS THE EQUIPMENT DESIGNATION, ACU, CU, EF, ETC.) IN ACCORDANCE WITH THE LABELING REQUIREMENTS IN SPEC BOOK.

E. BRANCH DUCT SIZE TO MATCH DIFFUSER NECK SIZE

F. ~~BOTTOM OF HVAC UNITS TO BE 12'-0" AFF IF ABLE TO DO SO WITH NO OBSTRUCTIONS (MALL DUCT, SPRINKLER MAINS, ETC.).~~

G. ALL EXPOSED DUCTWORK TO BE INTERNALLY LINED.

H. GC TO CHANGE OUT ALL FILTERS AFTER FINAL STORE CLEAN.

I. ~~DUCTWORK TO BE MOUNTED AT 13'-0" A.F.F. UNLESS NOTED OTHERWISE ON PLAN.~~

MECHANICAL PLAN CODED NOTES

1. EXISTING HVAC CONTROL DEVICE TO BE RECONFIGURED TO ACCOMMODATE NEW WORK. ADJUST AS REQUIRED FOR PROPER OPERATION. REFER TO E4.00 FOR ADDITIONAL INFORMATION.
2. NEW TEMPERATURE SENSOR. REFER TO SHEET M1.00 AND E4.00 FOR ADDITIONAL INFORMATION. FIELD VERIFY EXACT LOCATION AND ALL REQUIREMENTS WITH HOLLISTER CONSTRUCTION MANAGER PRIOR TO BID.
3. RTU-1 & RTU-2: OWNER FURNISHED, CONTRACTOR INSTALLED, ELECTRIC COOLING, GAS HEATING ROOFTOP UNIT COMPLETE WITH CURB. CONTRACTOR SHALL VERIFY MODEL NUMBERS AND ELECTRICAL REQUIREMENTS PRIOR TO INSTALLATION. CONTRACTOR TO CONTACT AND SCHEDULE TRANE TO HAVE UNITS STARTED UP PRIOR TO OWNER COMMISSIONING VENDOR ARRIVAL. CONTRACTOR TO REMOVE AND DISPOSE OF EXISTING RTU, ALL ASSOCIATED DUCT WORK, CURB AND ACCESSORIES. CONTRACTOR SHALL PROVIDE STEEL SUPPORT AS REQUIRED AND THREE SETS OF FILTERS. CHANGE FILTERS AFTER FINAL STORE CLEANING AND AGAIN PRIOR TO AIR BALANCE. MODIFY EXISTING ROOF OPENING AS REQUIRED. FIELD VERIFY EXACT LOCATION, SIZE AND ALL OTHER REQUIREMENTS. ALL ROOF WORK TO BE PERFORMED BY A LANDLORD APPROVED ROOFING CONTRACTOR AT THIS CONTRACTOR'S EXPENSE. LABEL ROOFTOP UNIT PER LANDLORD REQUIREMENTS AND PER SPECIFICATIONS. SEE HVAC EQUIPMENT SCHEDULE FOR MORE INFORMATION.
4. CONTRACTOR SHALL PROVIDE A CONDENSATE DRAIN FROM EACH PIECE OF HVAC EQUIPMENT. DRAIN SHALL BE 1" MINIMUM AND HAVE A TRAP DEPTH OF 1.5"xUNIT TOTAL STATIC PRESSURE (MINIMUM 5" DEEP). PIPING TO SLOPE TOWARD OUTLET AT A MINIMUM OF 1 INCH FOR EVERY 10 FEET AND SHALL BE WROUGHT COPPER TUBING AND FITTINGS WITH FULLY SOLDERED JOINTS. ROUTE DRAINS TO THE NEAREST ROOF DRAIN OR DOWNSPOUT OR OTHER APPROVED LANDLORD AND AHJ APPROVED RECEPTOR WITH CODE REQUIRED AIR GAP. FIELD VERIFY AND COORDINATE ROUTING, SLOPE, MATERIALS, OUTLET AND ALL OTHER REQUIREMENTS.
5. CONTRACTOR SHALL PROVIDE AIR CONNECTIONS FULL SIZE OF OPENINGS WITH FLEXIBLE DUCT CONNECTIONS. TRANSITION TO DUCT SIZE SHOWN AS REQUIRED.
6. PROVIDE A 1"X1" ALUMINUM WIRE MESH SCREEN OVER THE END OF THE RETURN AIR OPENING. PROVIDE A MANUAL BALANCING DAMPER IN THE RETURN AIR DUCT AND BALANCE TO CFM LISTED ON M1.00
7. PROVIDE AN AIR CURTAIN AS SCHEDULED ON SHEET M1.00 WITH OPTIONAL REMOTE THERMOSTAT WITH LOCKING COVER. CURTAIN IS TO BE RECESSED IN CEILING, WITH BOTTOM PANEL EXPOSED - REFER TO M1.00 FOR MORE INFORMATION REGARDING FINISH REQUIREMENTS. INSTALL PER THE MANUFACTURER'S RECOMMENDATIONS AND INSTALLATION INSTRUCTIONS. THE CURTAIN SHALL ONLY OPERATE DURING OCCUPIED HOURS. THE UNIT SHALL TURN ON WHEN THE FACTORY-FURNISHED (FIELD INSTALLED) DOOR SWITCH DETECTS THE ENTRY DOOR OPENING. UPON THE ENTRY DOOR CLOSING THE UNIT SHALL SHUT OFF AFTER A SHORT DELAY TO PREVENT POWER CYCLING. THE UNIT SHALL ALSO BE OFF DURING UNOCCUPIED PERIODS WHEN THE STORE IS NOT IN OPERATION. THE AIR CURTAIN SHALL ONLY BE USED AS AN AIR BARRIER FOR EXTERIOR AND INTERIOR AIR AND SHALL NOT BE USED TO HEAT OR COOL THE TENANT SPACE. THIS CONTRACTOR IS TO ENSURE A FULLY FUNCTIONING SYSTEM AND THAT THE AIR CURTAIN OPERATES WITHIN THESE PARAMETERS. FIELD VERIFY AND COORDINATE ALL REQUIREMENTS PRIOR TO BID.
8. DASHED LINE AROUND HVAC EQUIPMENT REPRESENTS MANUFACTURER'S RECOMMENDED CLEARANCES FOR EQUIPMENT MAINTENANCE. IT IS THE CONTRACTOR'S RESPONSIBILITY TO MAINTAIN SERVICE CLEARANCES THE FULL HEIGHT OF THE UNIT IN THIS AREA.
9. CONTRACTOR TO PROVIDE A ELECTRIC SLIP-IN DUCT HEATER AS SCHEDULED ON SHEET M1.00. UNIT SHALL BE UL LISTED AND MOUNTED IN DUCT AS INDICATED ON PLAN. UNIT SHALL BE INSTALLED PER MANUFACTURER'S REQUIREMENTS. PROVIDE DUCT TRANSITIONS ON EACH SIDE OF HEATER AS REQUIRED. HEATER SHALL BE INTERLOCKED AS INDICATED ON SHEET M1.00. FIELD VERIFY AND COORDINATE ALL REQUIREMENTS PRIOR TO BID.
10. ALL HVAC EQUIPMENT OR OTHER MECHANICAL DEVICES IN HATCHED AREAS ARE TO REMAIN AS-IS UNLESS OTHERWISE NOTED ON THE ARCHITECTURAL DEMOLITION PLAN.
11. EXISTING SMOKE DETECTOR, THAT SERVED THE EXISTING ROOFTOP UNITS IN THE SAME LOCATION AS NEW, IS TO BE RELOCATED. INSTALLATION IN THE RETURN AIR PATH IS TO BE BY THIS CONTRACTOR WITH WIRING TO BE BY THE LANDLORD'S PREFERRED FIRE ALARM CONTRACTOR AT THIS CONTRACTOR'S EXPENSE. UPON DETECTION OF SMOKE, DETECTOR SHALL SIGNAL TENANT/LANDLORD FIRE ALARM SYSTEM AND UNIT SHALL SHUT DOWN. FIELD VERIFY AND COORDINATE ALL REQUIREMENTS WITH LANDLORD AND LANDLORD'S REQUIRED FIRE ALARM CONTRACTOR PRIOR TO BID AND INCLUDE ALL MATERIAL AND LABOR COSTS FOR THIS WORK IN BID.
12. CONTRACTOR TO REUSE EXISTING DUCTWORK. CAP ANY UNUSED OPENINGS IN EXISTING DUCT WITH SAME GAUGE SHEET METAL AND SEAL AIR-TIGHT. REPAIR INSULATION AND VAPOR BARRIER TO MATCH EXISTING. VERIFY EXISTING SUPPORTS AND PROVIDE NEW AS REQUIRED. FIELD VERIFY EXACT LOCATION AND ALL REQUIREMENTS.
13. CONTRACTOR SHALL REUSE EXISTING AIR DEVICE. CLEAN AND ADJUST AS REQUIRED FOR PROPER OPERATION. FIELD VERIFY EXACT LOCATION AND ALL REQUIREMENTS. REBALANCE AS NOTED.
14. CONTRACTOR SHALL REUSE EXISTING AIR DEVICE. CLEAN AND ADJUST AS REQUIRED FOR PROPER OPERATION. FIELD VERIFY EXACT LOCATION AND ALL REQUIREMENTS.
15. CONTRACTOR SHALL RELOCATE EXISTING AIR DEVICE AND EXTEND ASSOCIATED DUCTWORK TO THE EXISTING DUCT LOCATION AND CONNECT - ANY NEW DUCTWORK, THAT IS CONNECTING TO EXISTING, IS TO MATCH EXISTING TYPE AND SIZE. REPAIR INSULATION AND VAPOR BARRIER TO MATCH EXISTING. CLEAN AND ADJUST AS REQUIRED FOR PROPER OPERATION. FIELD VERIFY EXACT LOCATION AND ALL REQUIREMENTS PRIOR TO BID.
16. ROUTE DUCT FROM TRANSFER GRILLE TO ABOVE SALES FLOOR CEILING AS INDICATED ON PLAN. PROVIDE 1"X1" WIRE MESH ON OPEN END OF DUCT. FIELD VERIFY AND COORDINATE ALL REQUIREMENTS.
17. REUSE EXISTING ZONE DAMPER. CLEAN AND ADJUST AS REQUIRED FOR PROPER OPERATION. REPLACE/REPAIR ANY DEFECTIVE PARTS. FIELD VERIFY EXACT LOCATION AND ALL REQUIREMENTS.

HOLLISTER
CALIFORNIA

ABERCROMBIE & FITCH CO.
6301 FITCH PATH
NEW ALBANY, OHIO 43054
614-283-6500

SHREMSHOCK
Shremshock Engineering, Inc.
7775 Walton Parkway Ste. 250 New Albany, OH 43054
t: 614.545.4500 | f: 614.545.4555
info@shremshock.com
www.shremshock.com

THE ARCHITECT / ENGINEER ASSUMES NO RESPONSIBILITY OR LIABILITY FOR THE USE OF THESE PLANS FOR ANY PROJECT OTHER THAN SPECIFICALLY AUTHORIZED BY THEM AND SIGNED AND SEALED FOR SUCH SPECIFIC LOCATION IN THE STATE WHERE THE PROJECT IS LOCATED. WHERE SEAL THE BUILDING USE IS ONLY APPLICABLE IN AREAS MEETING THE STATED DESIGN CRITERIA.

THE AVENUE OF MURFREESBORO
2615 MEDICAL CENTER PARKWAY
MURFREESBORO, TN 37129
STORE #3684

Project No.:	260356
Drawn By:	NRE
Date	Issue
10-12-2026	BID SET

MECHANICAL PLAN

M2.00

Plot date: OCT 13 2025